

SUITE: 1000

RSF: 11,287





AS-BUILT CONFIGURATION

- OFFICES.....2
- RECEPTION.....1
- CONFERENCE ROOMS.....3
- KITCHEN.....1
- OPEN WORK AREA..... +/- 58

KEY PLAN:

Not to scale, furniture and appliances not included

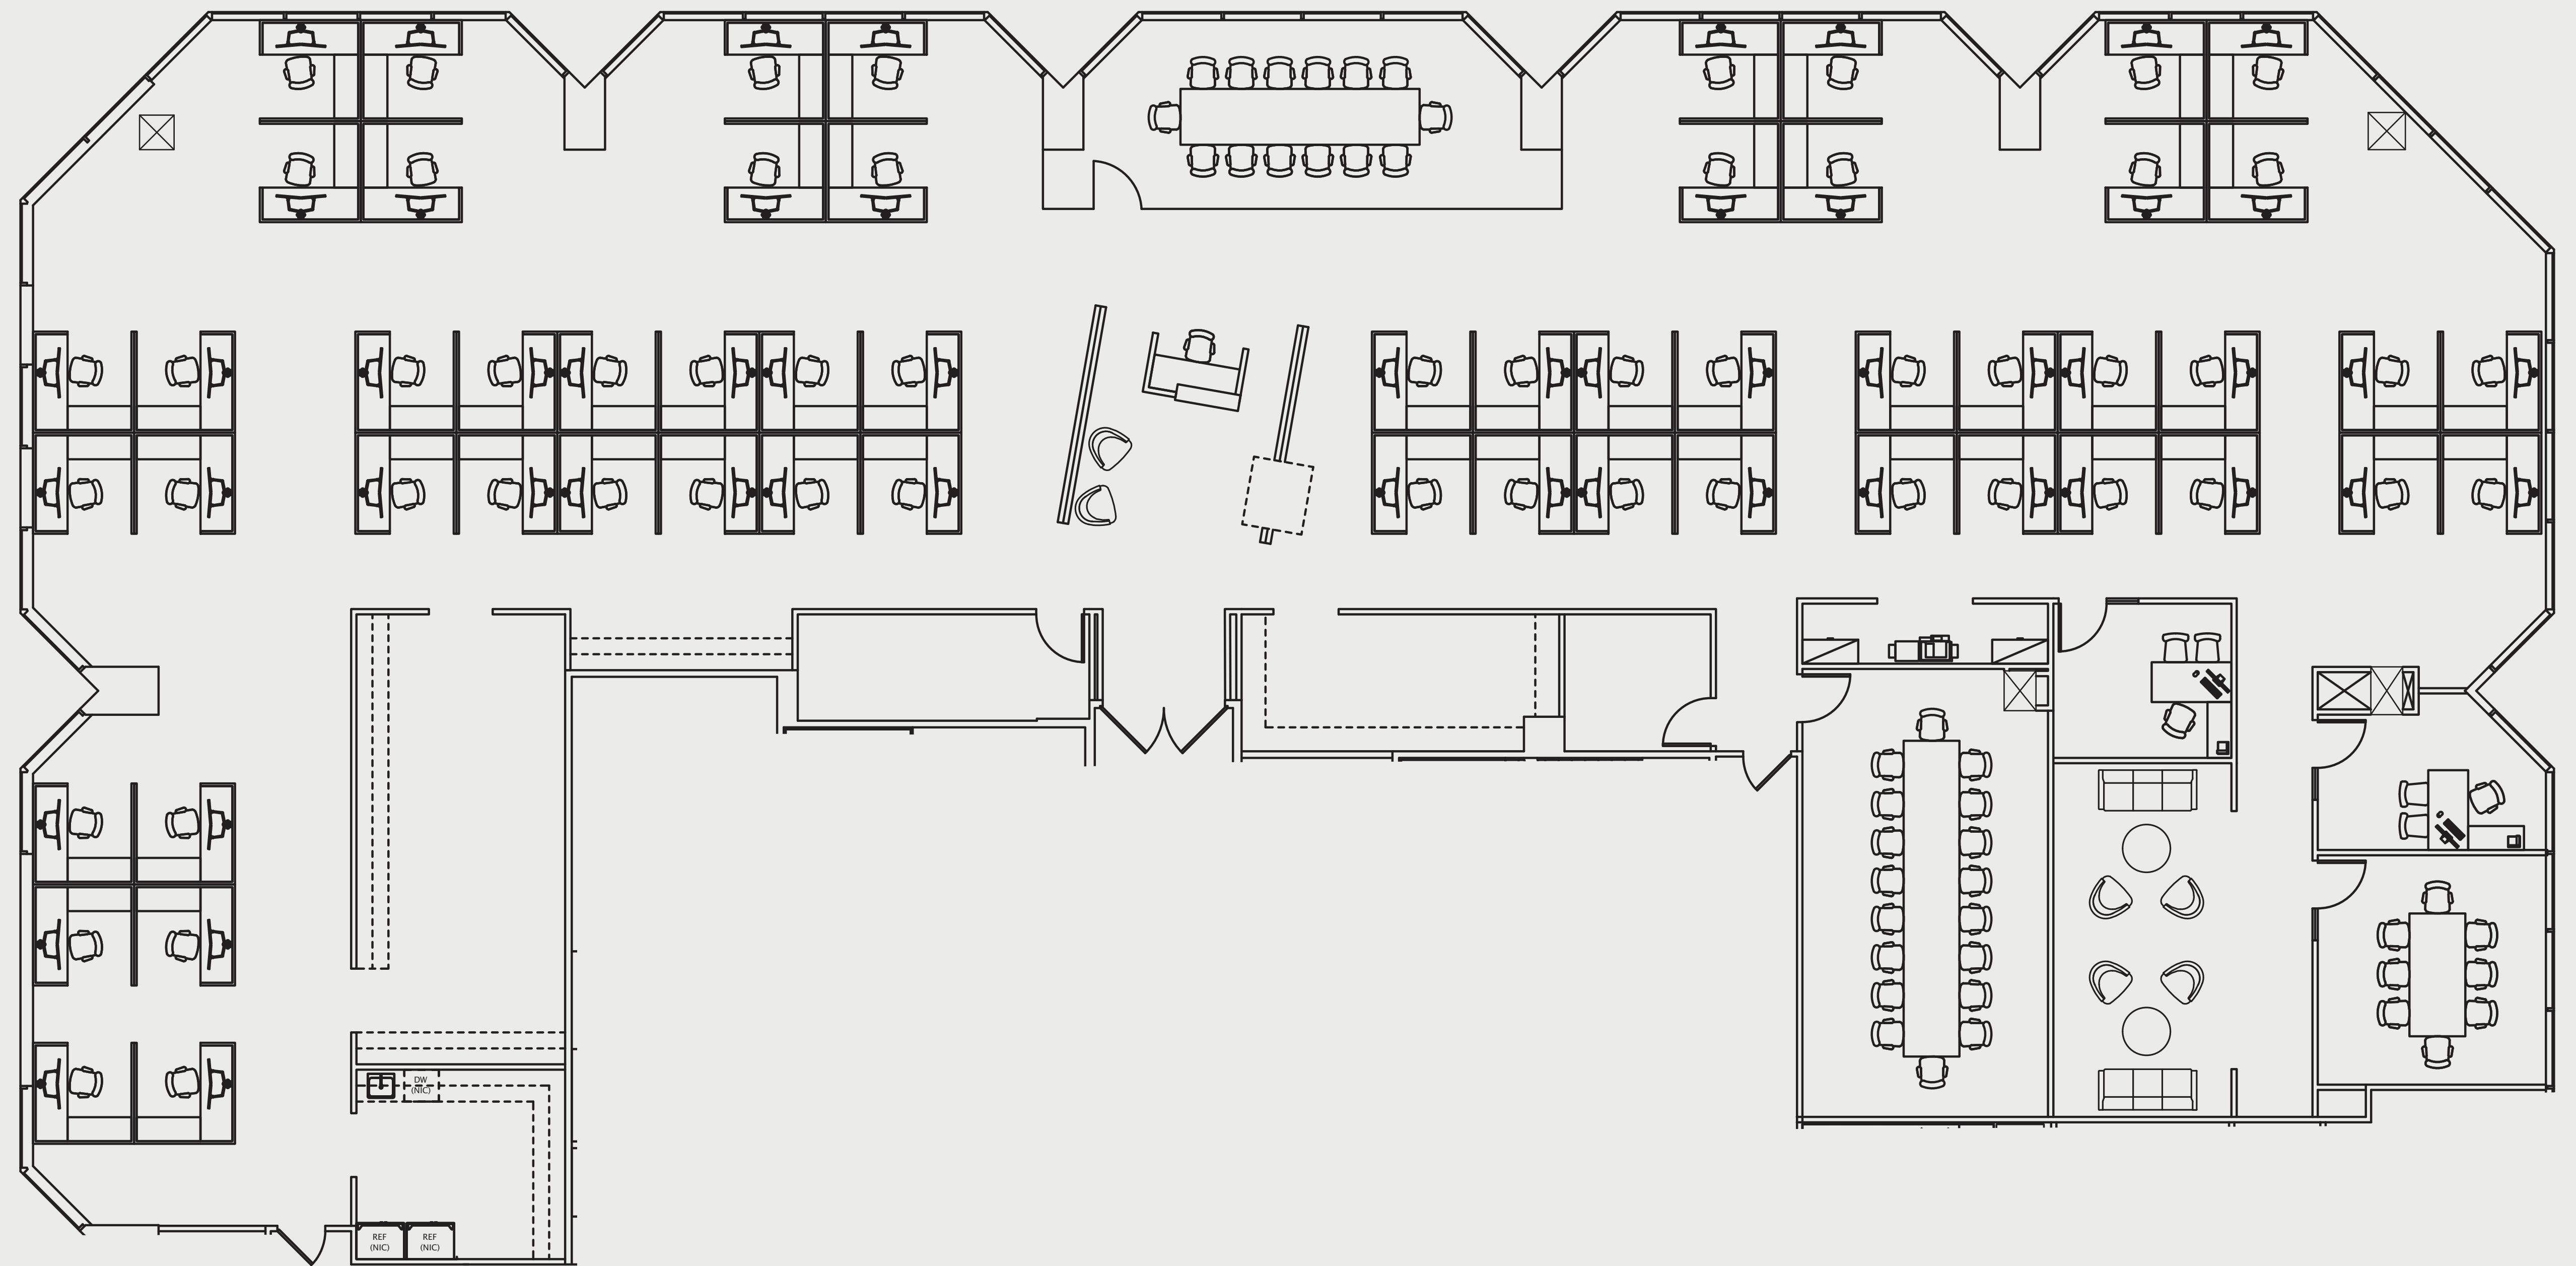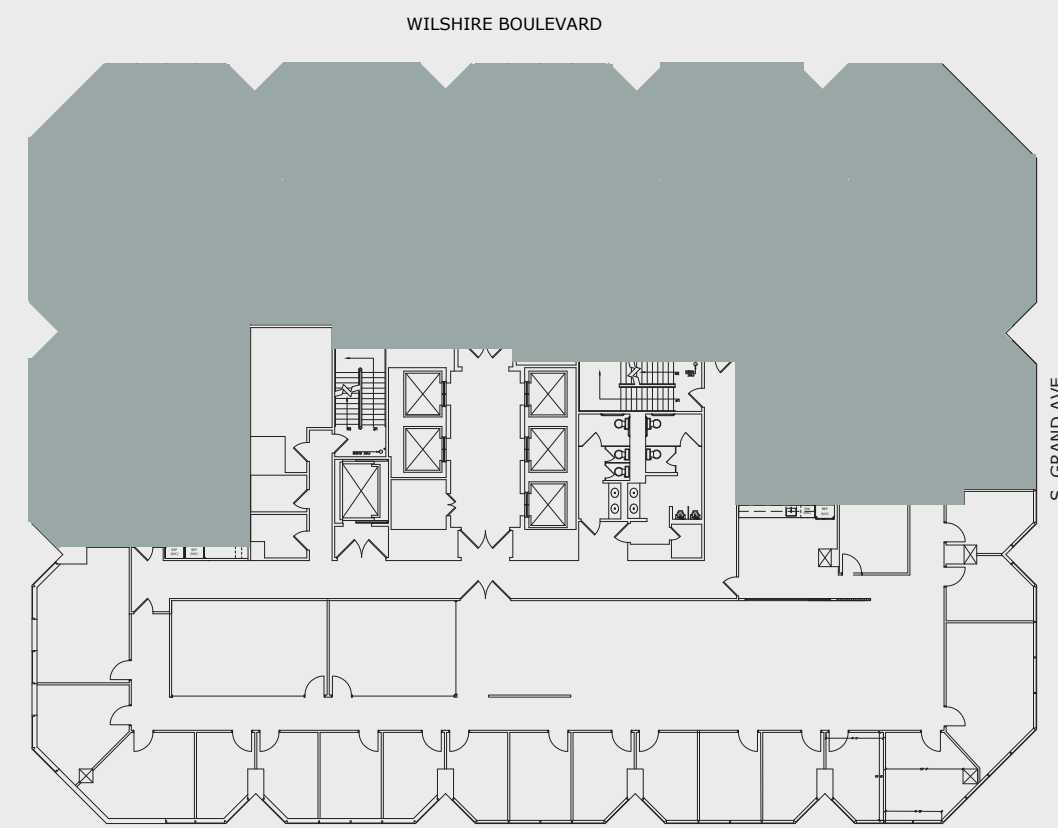

For leasing information please contact:
USALEASING@ONNI.COM
(213) 629-2041

