

# SUITE: 1000

# RSF: 11,287





## AS-BUILT CONFIGURATION

- OFFICES.....2
- RECEPTION.....1
- CONFERENCE ROOMS.....3
- KITCHEN.....1
- OPEN WORK AREA..... +/- 58

### KEY PLAN:

*Not to scale, furniture and appliances not included*

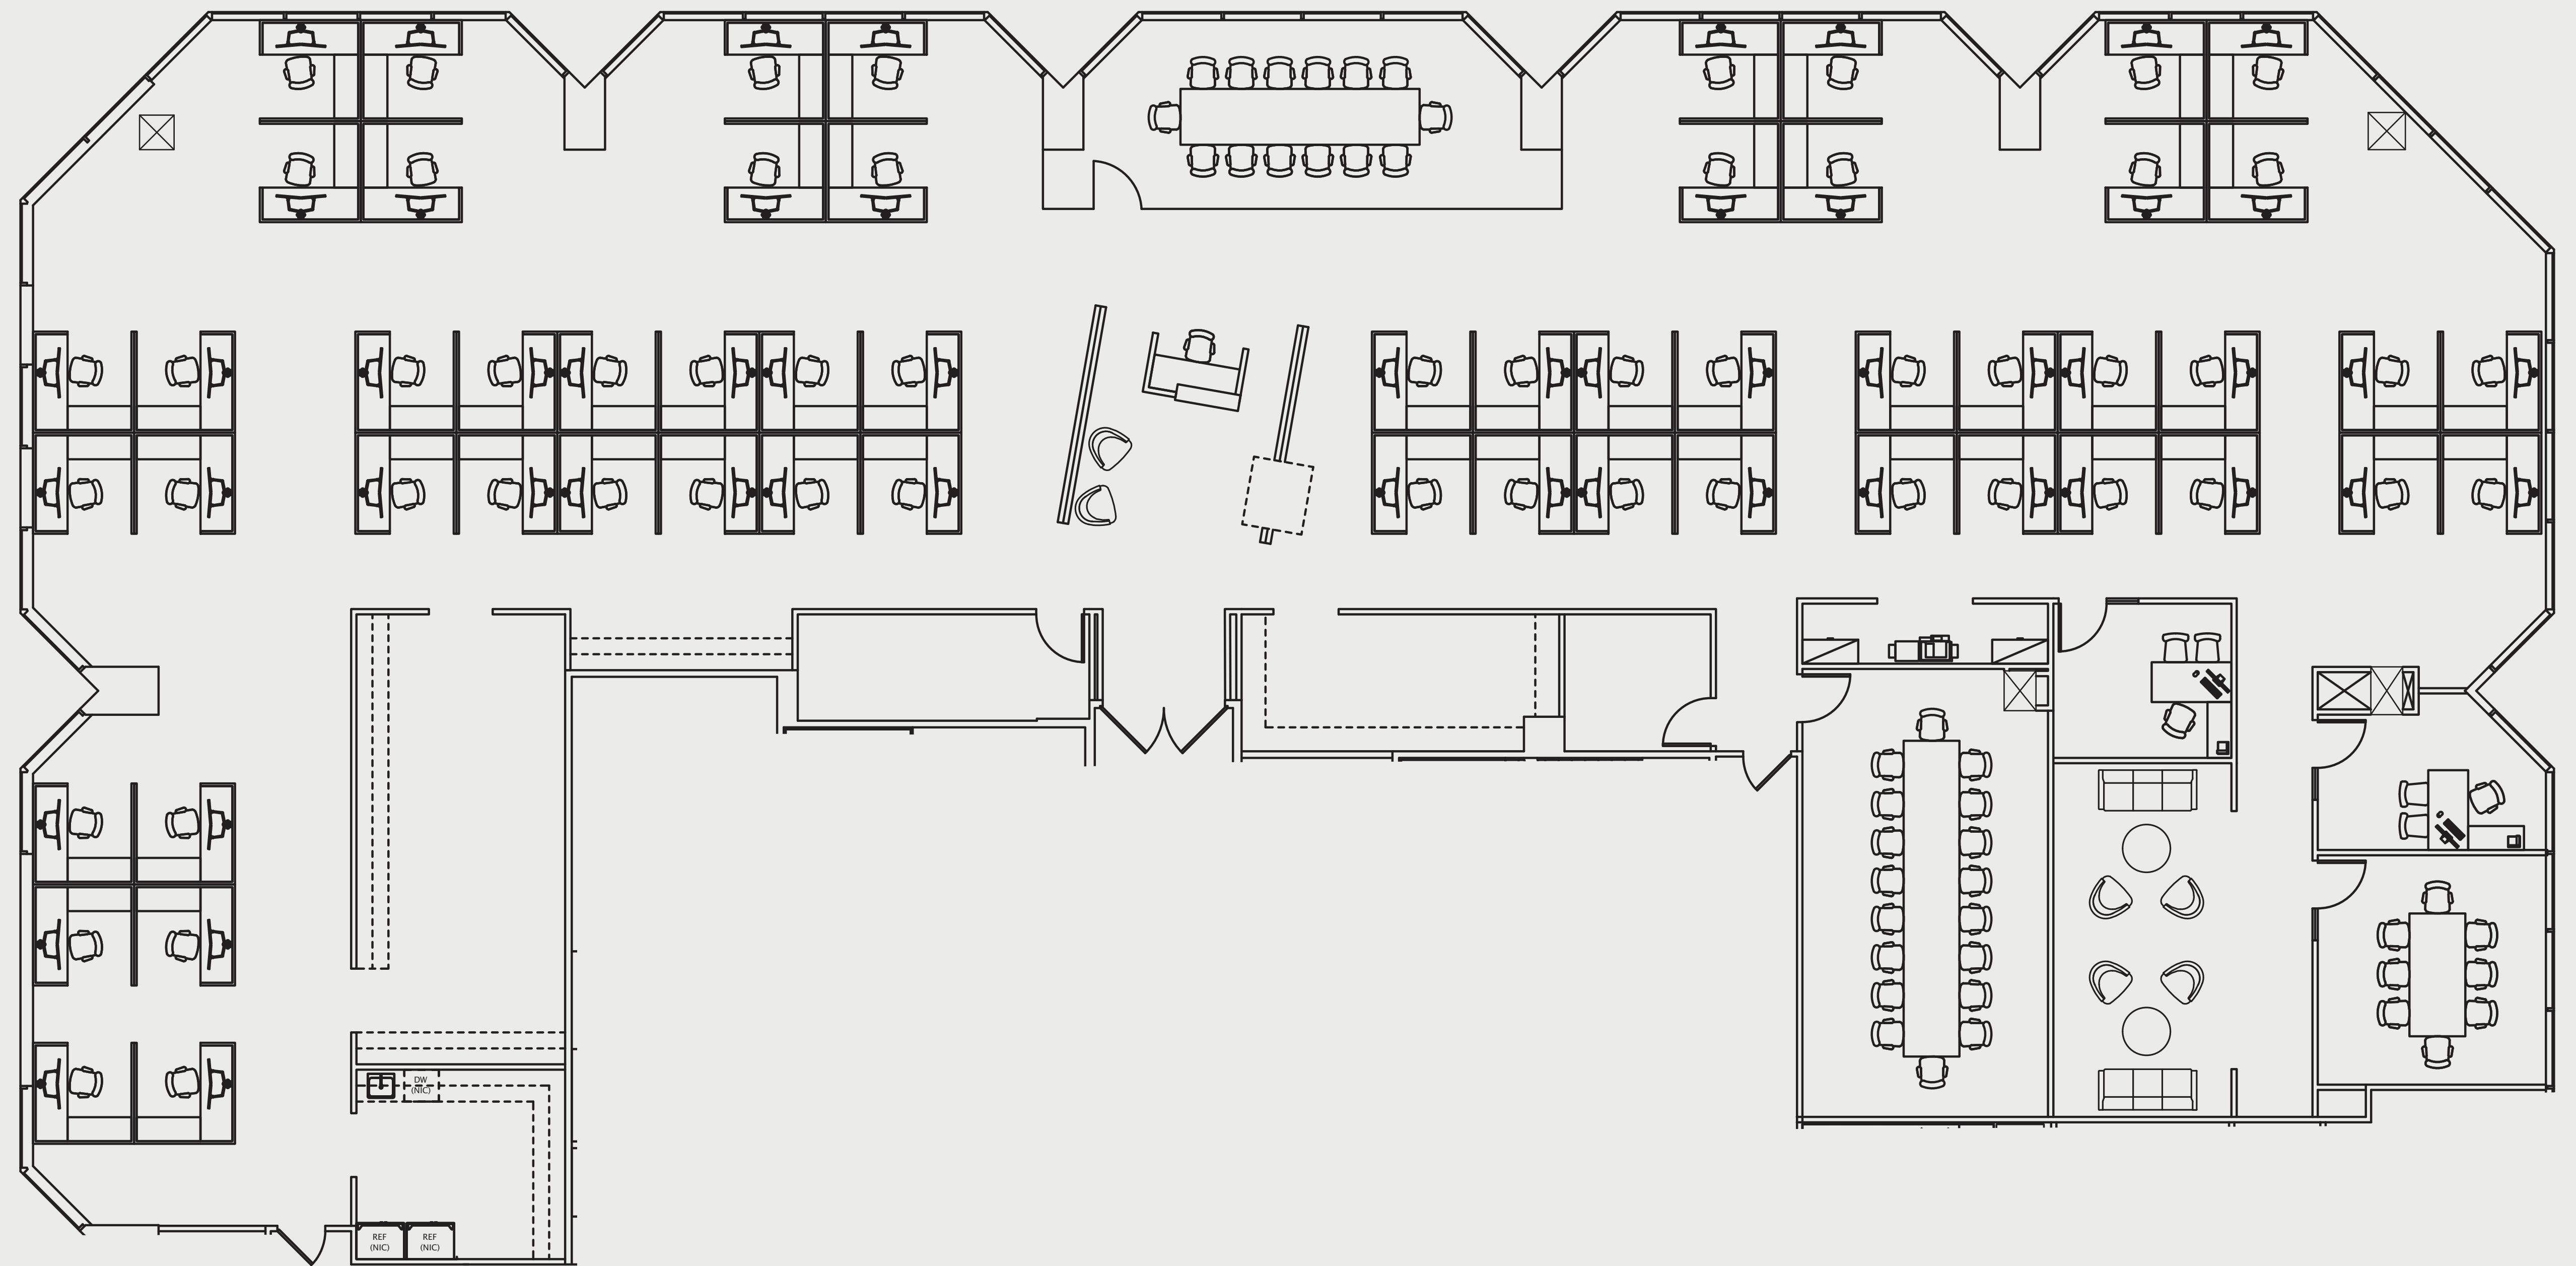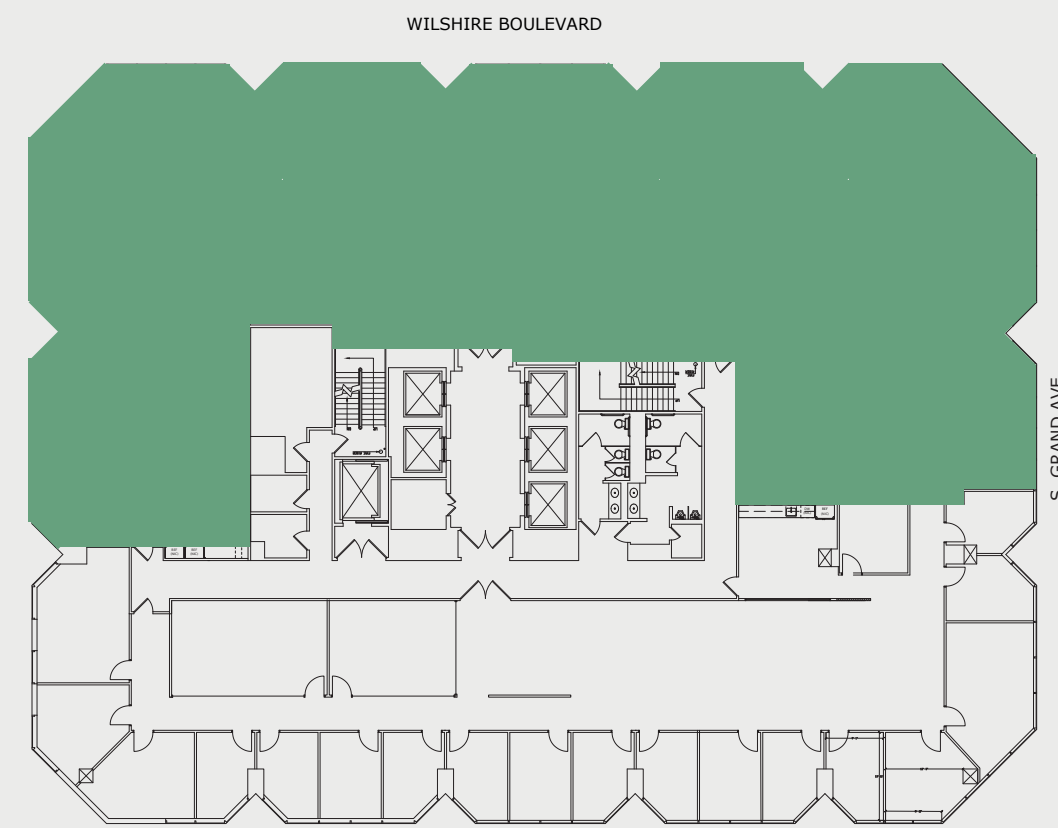

For leasing information please contact:  
Andrew Tashjian  
213.955.5148 [andrew.tashjian@cushwake.com](mailto:andrew.tashjian@cushwake.com)

