


## AS-BUILT CONFIGURATION

PRIVATE OFFICES.....6

KITCHEN.....1

OPEN WORK AREA.....+/- 8

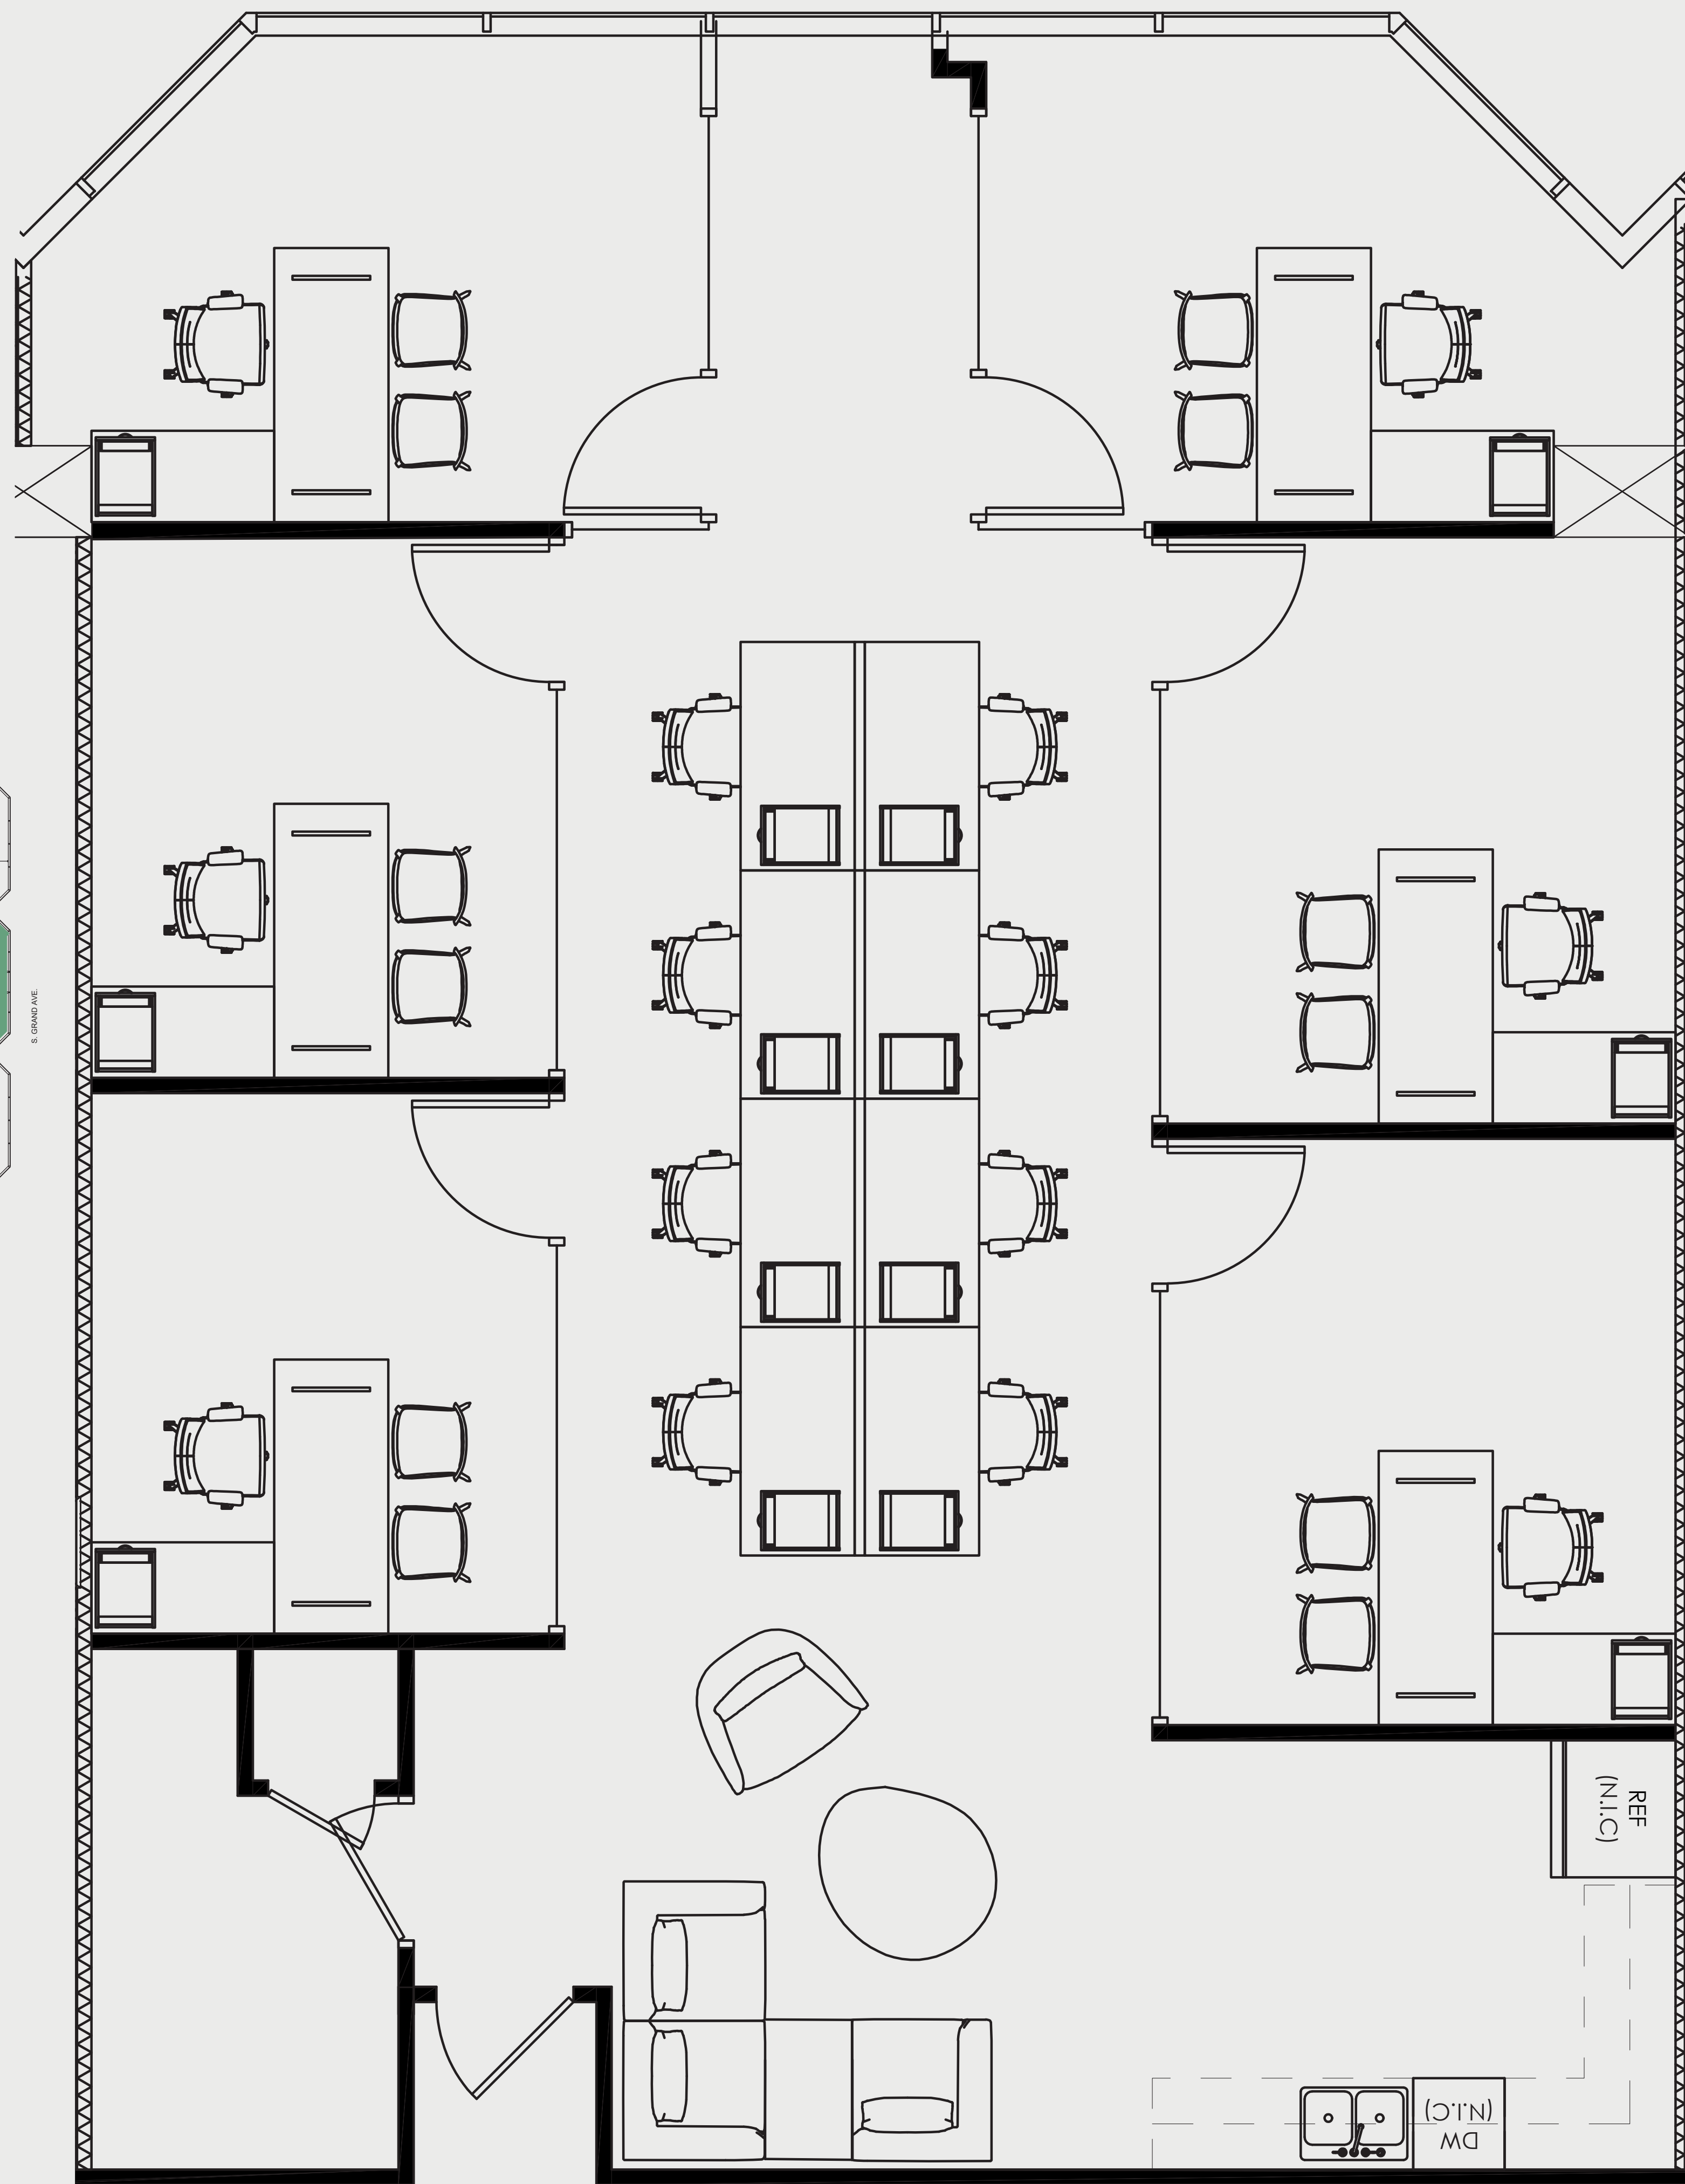

## KEY PLAN:

*Not to scale, furniture and appliances not included*

