

SUITE: 1450

RSF: 2,787





AS-BUILT CONFIGURATION

- OFFICES..... 4
- RECEPTION..... 1
- CONFERENCE ROOMS..... 1
- KITCHEN..... 1
- OPEN WORK AREA..... +/- 10

KEY PLAN:

*Not to scale, furniture and appliances not included*

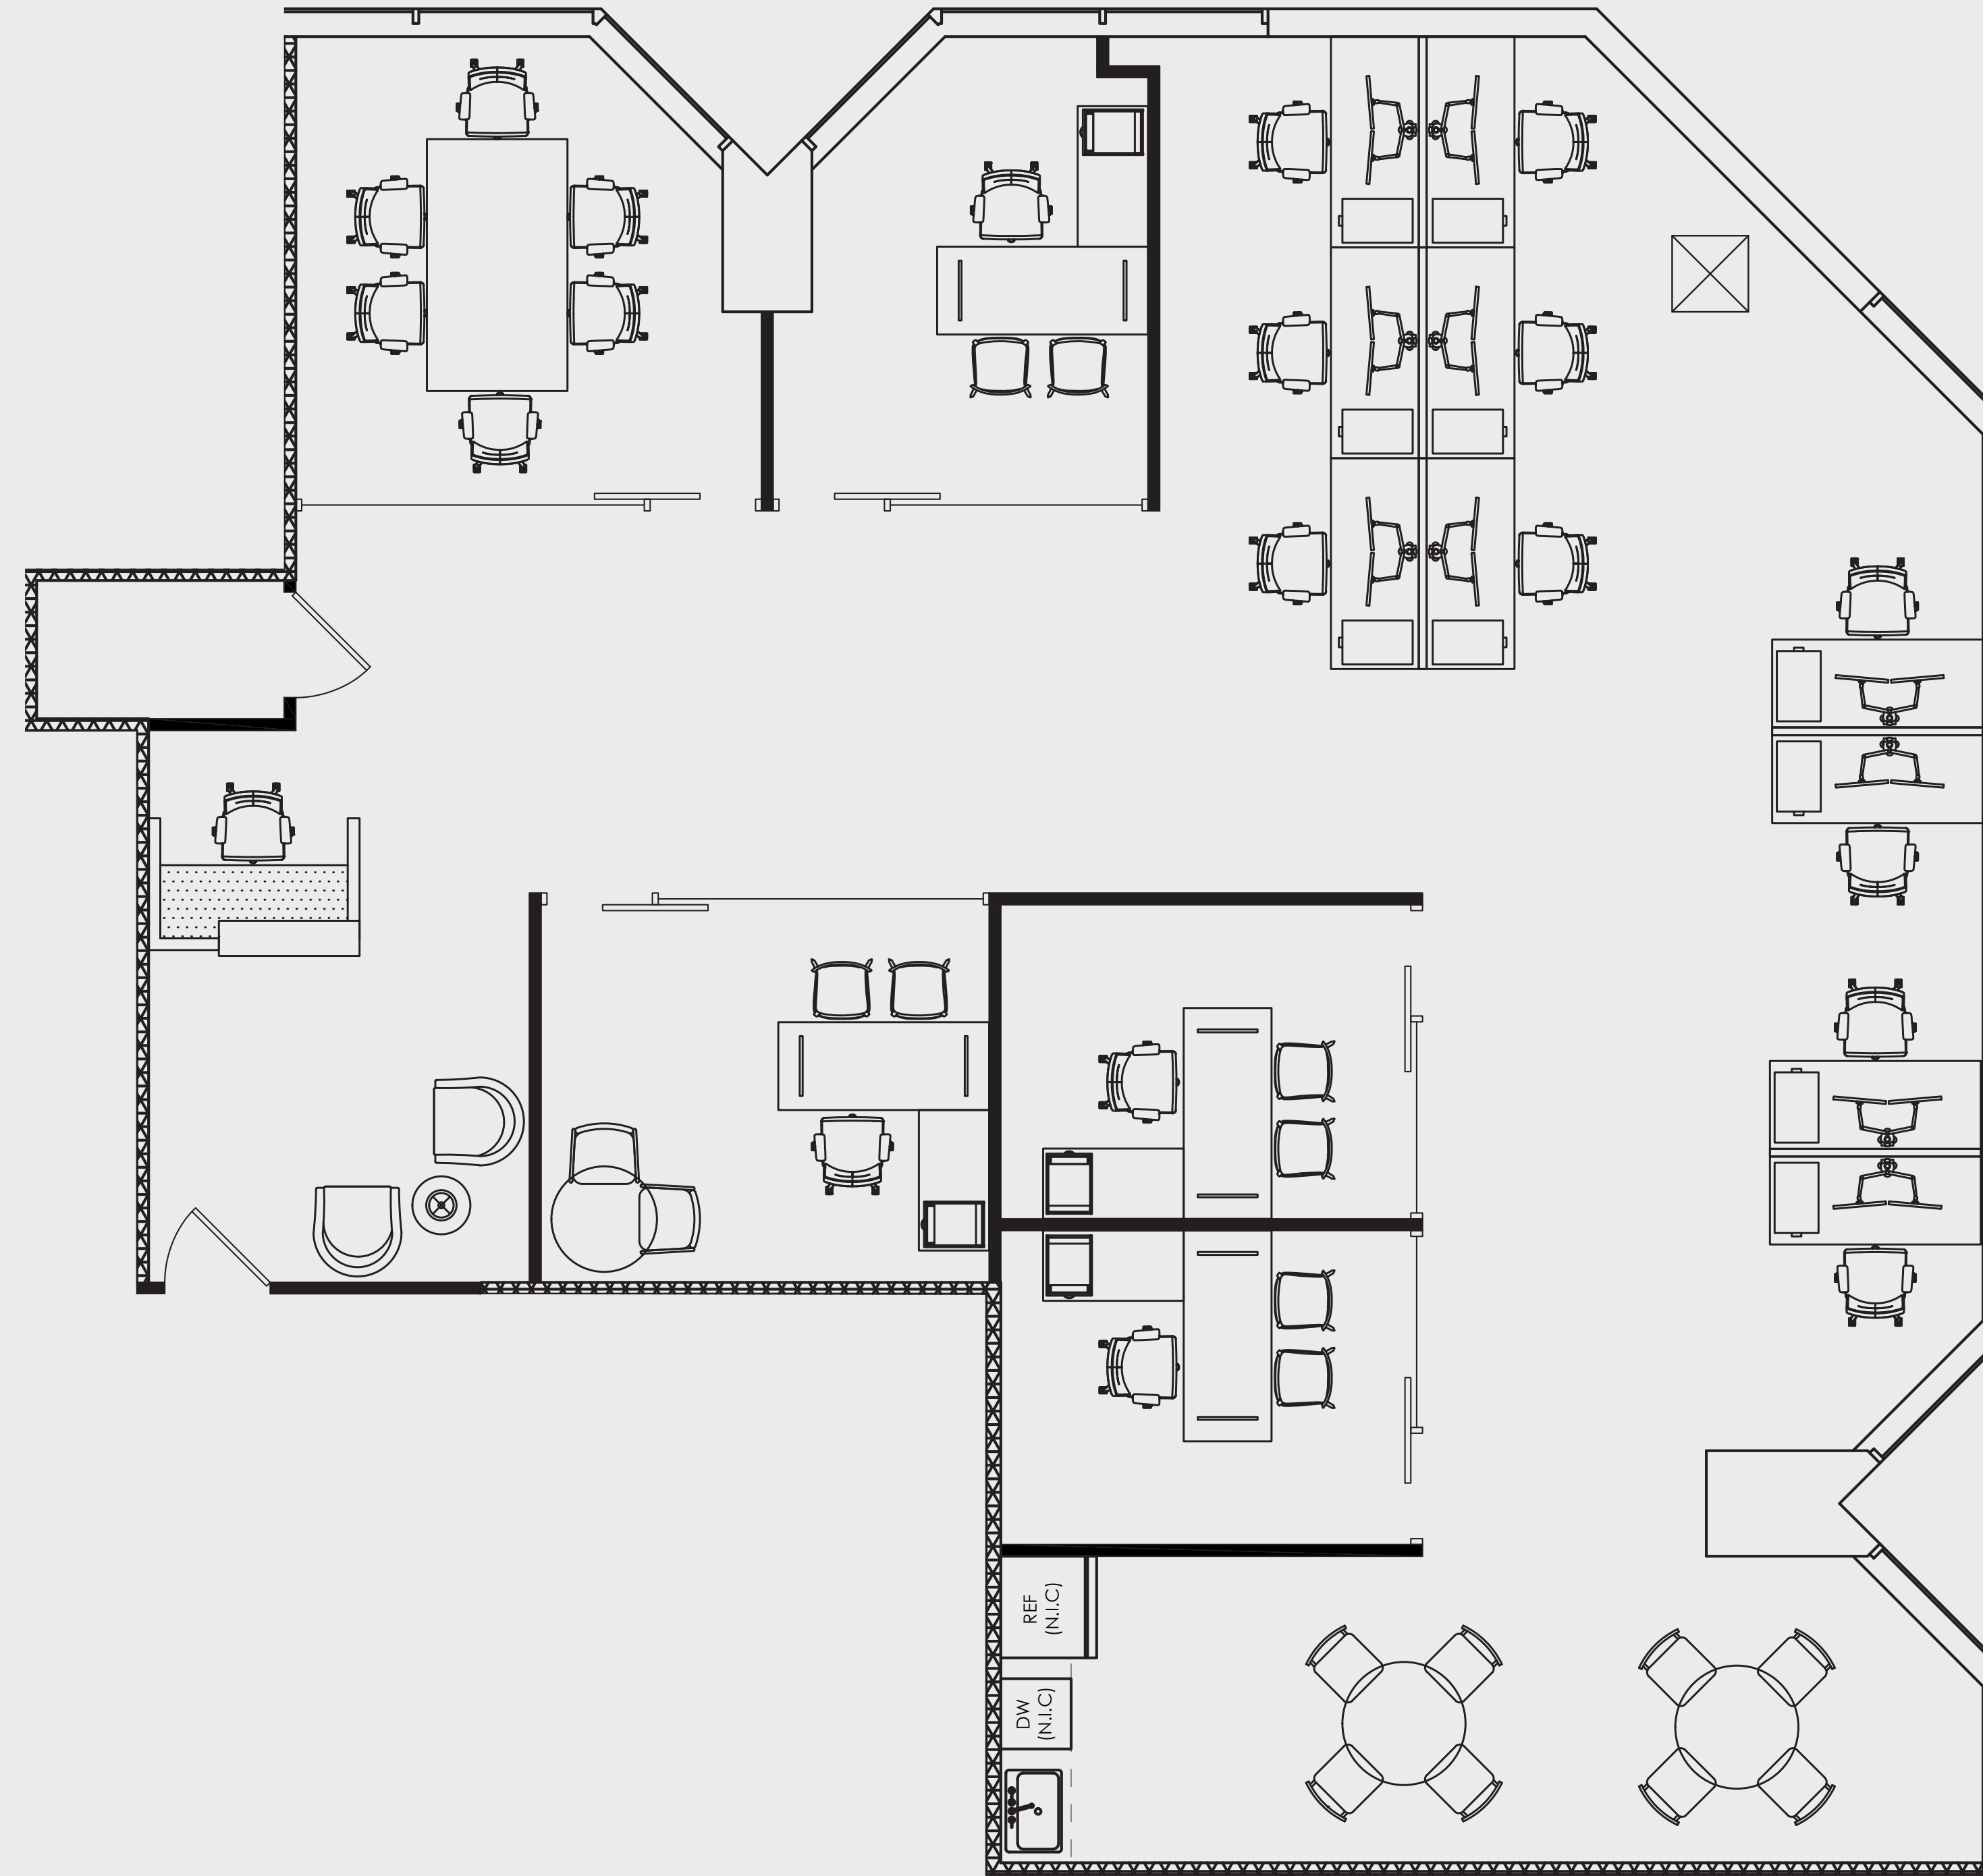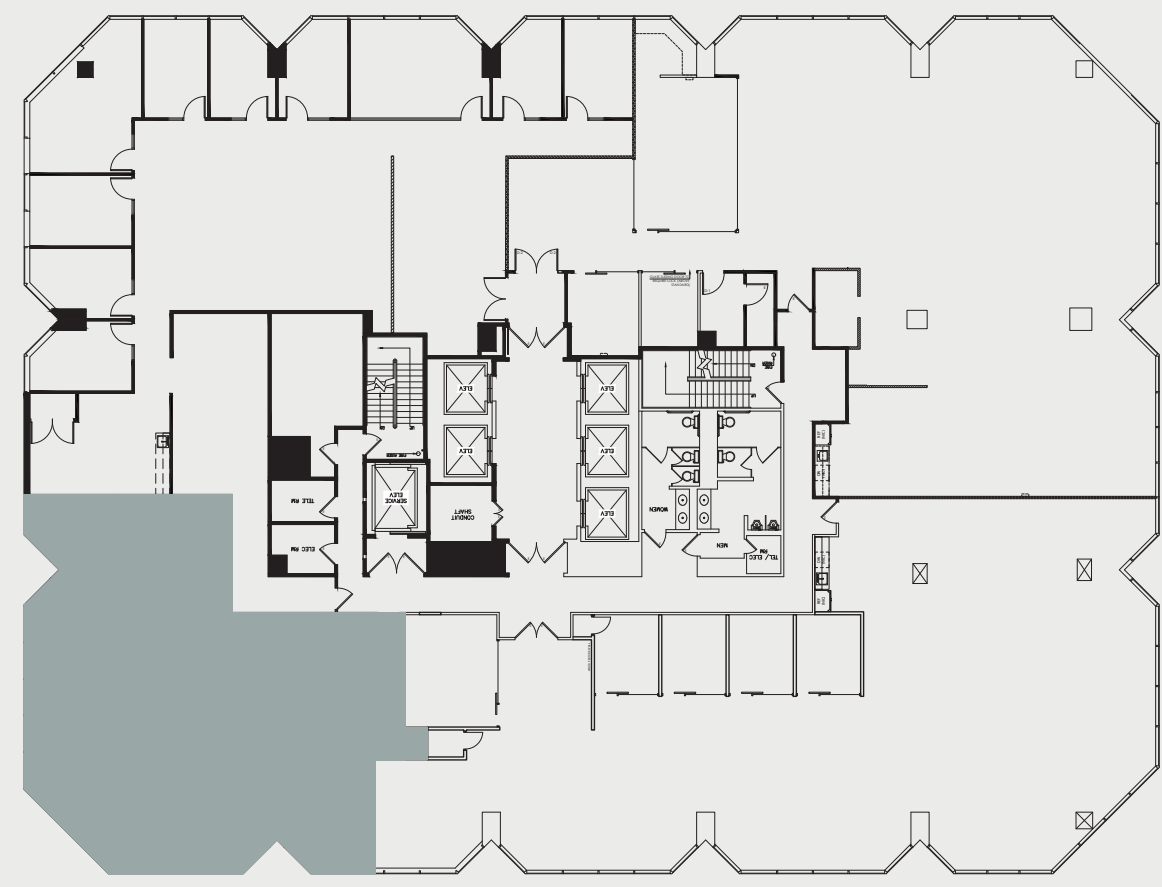

For leasing information please contact:  
USALEASING@ONNI.COM  
(213) 629-2041

