


SUITE: 1460

RSF: 5,435




AS-BUILT CONFIGURATION

- OFFICES..... 5
- RECEPTION..... 1
- CONFERENCE ROOMS..... 3
- KITCHEN..... 1
- OPEN WORK AREA..... +/- 27

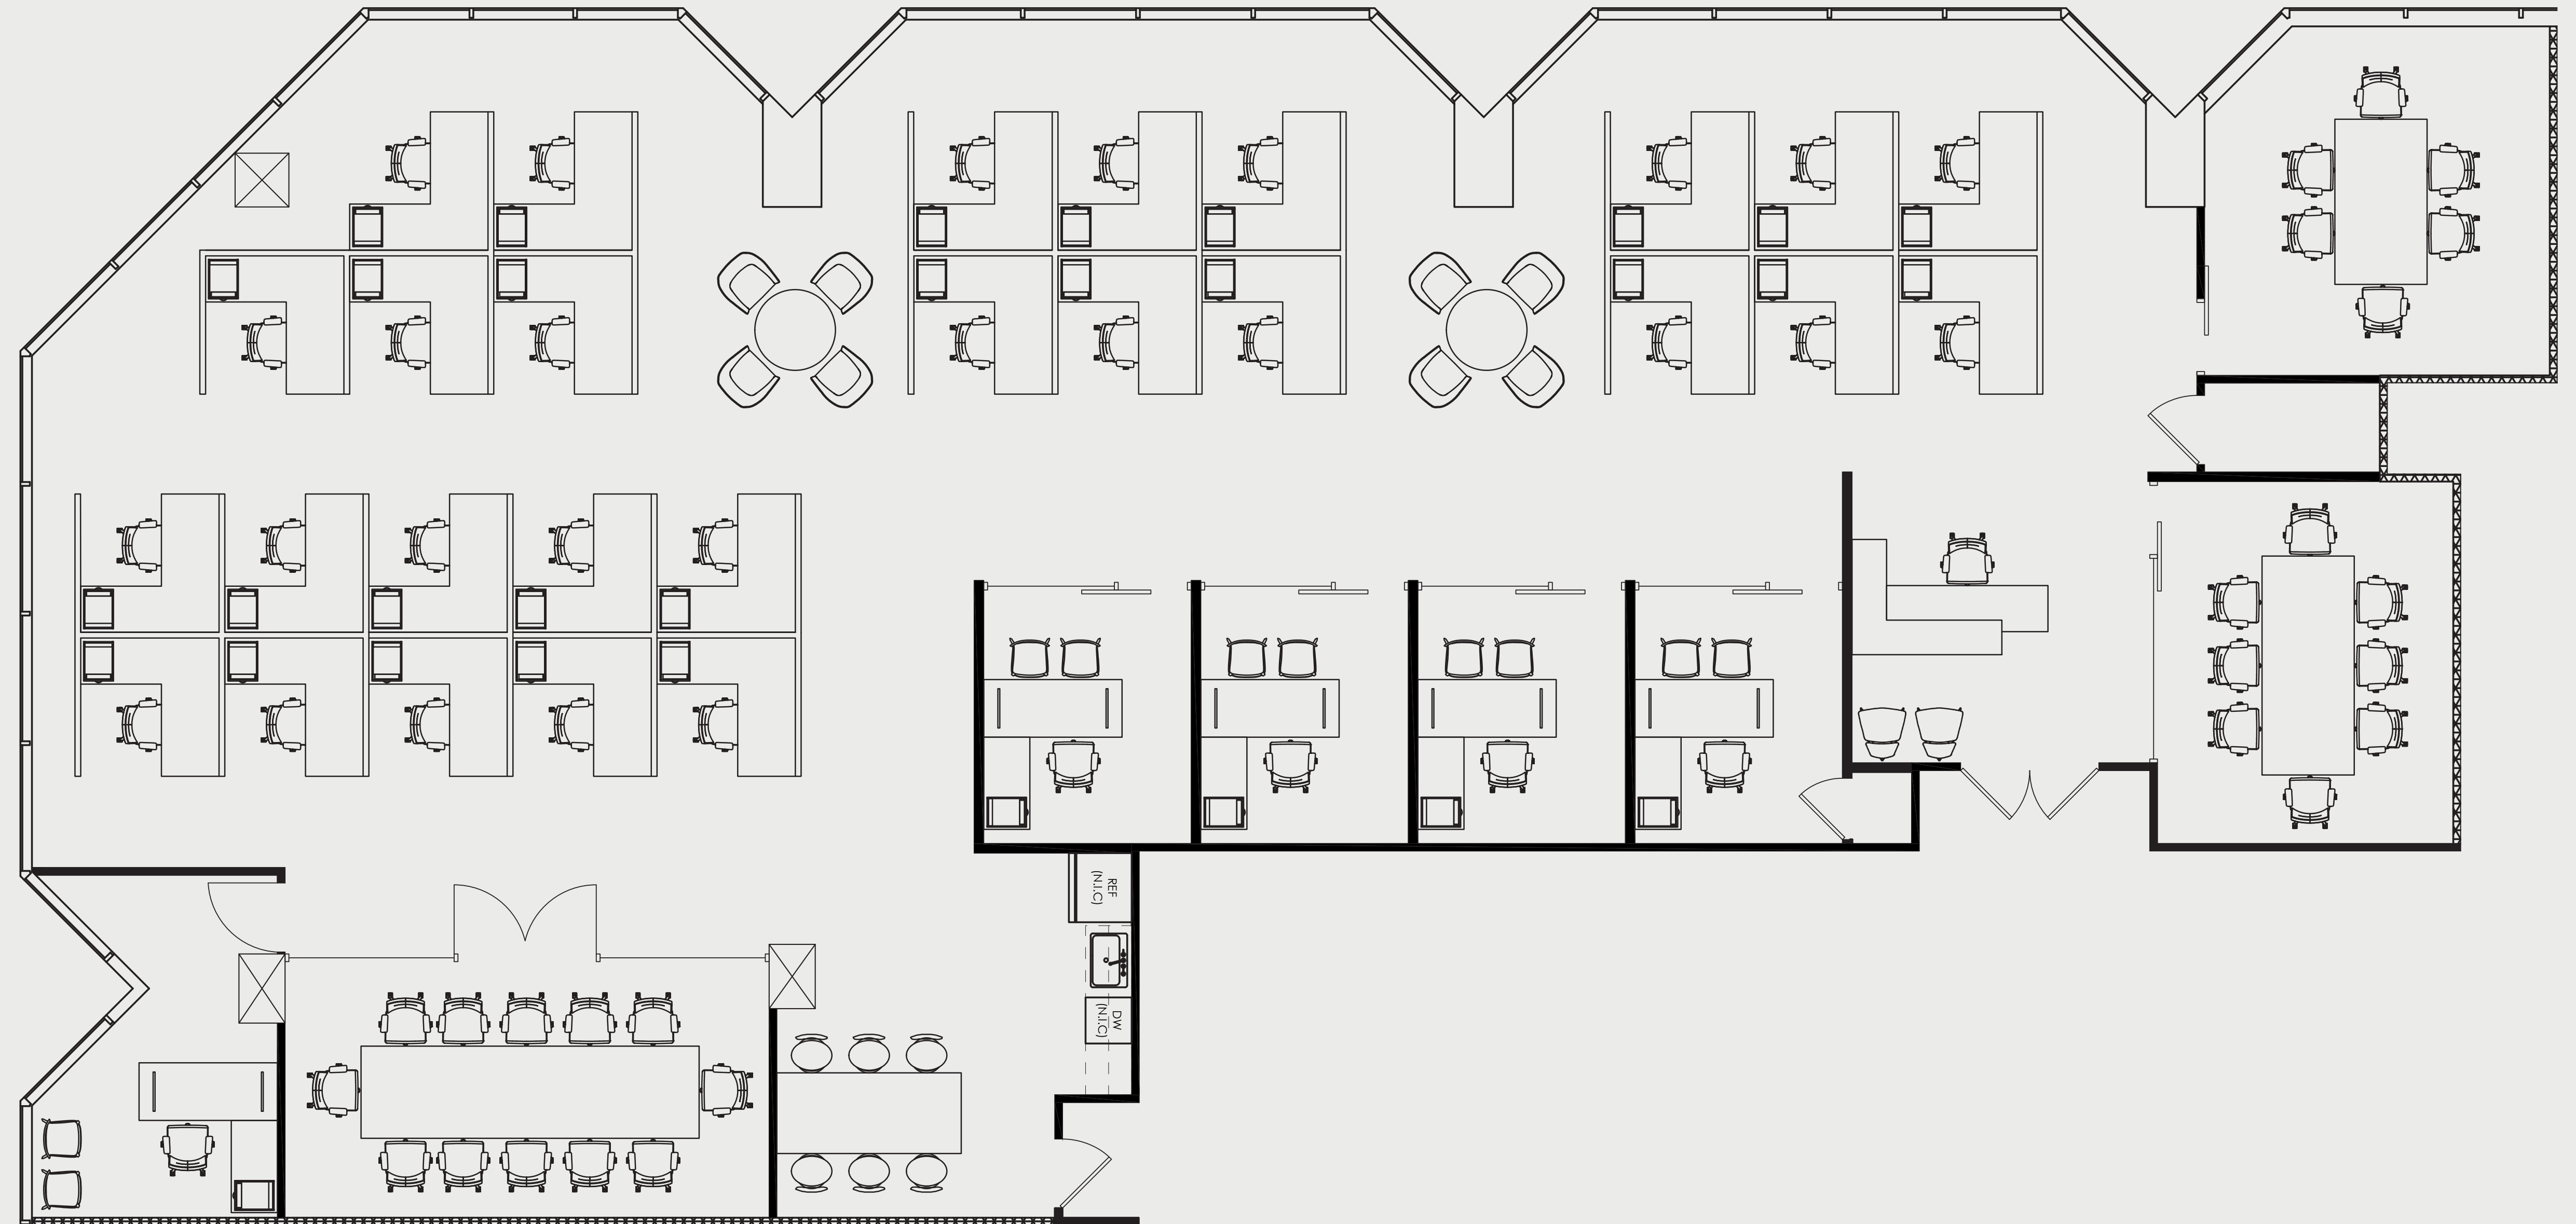

KEY PLAN:

Not to scale, furniture and appliances not included

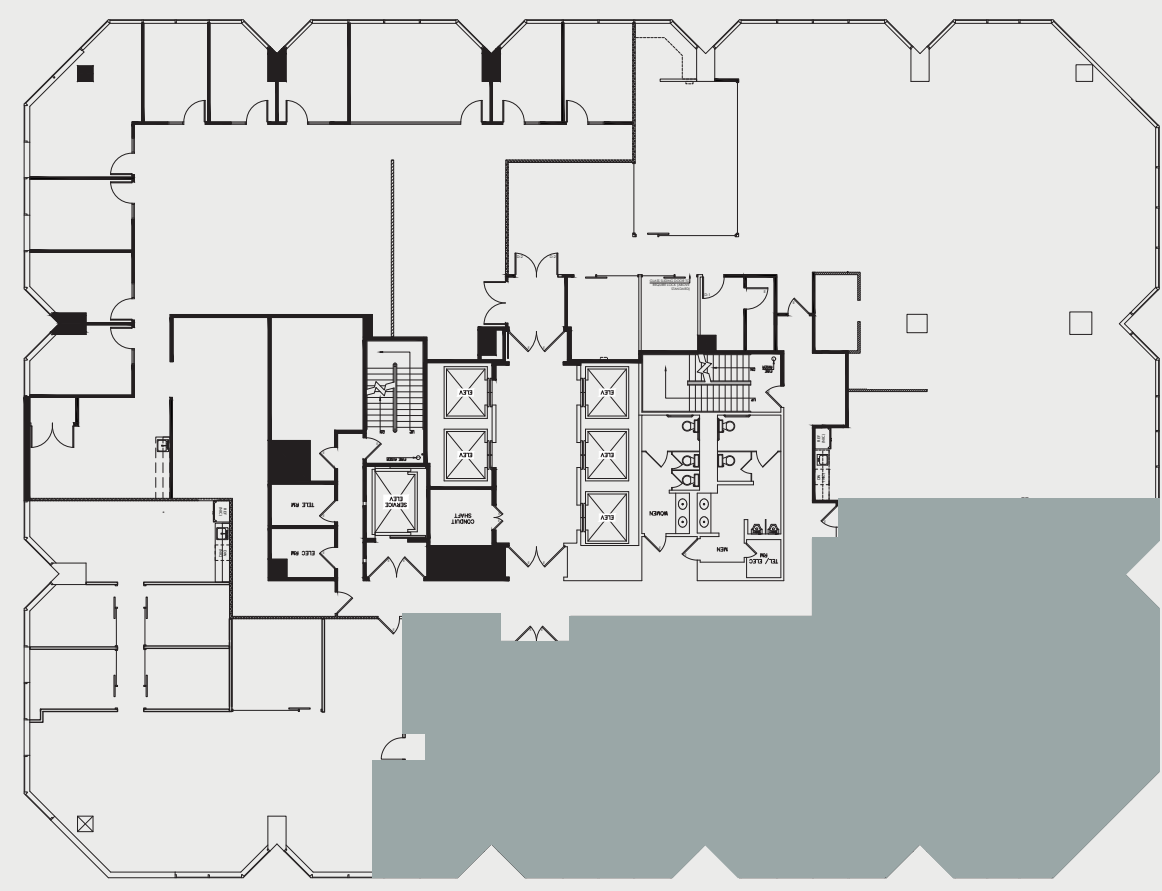

For leasing information please contact:
USALEASING@ONNI.COM
(213) 629-2041

