

RSF: 3,854 SUITE: 1500

AS-BUILT CONFIGURATION

OFFICES	3
RECEPTION	1
CONFERENCE ROOMS	.1
KITCHEN	1
OPEN WORK AREA	+/- 28

KEY PLAN: Not to scale, furniture and appliances not included

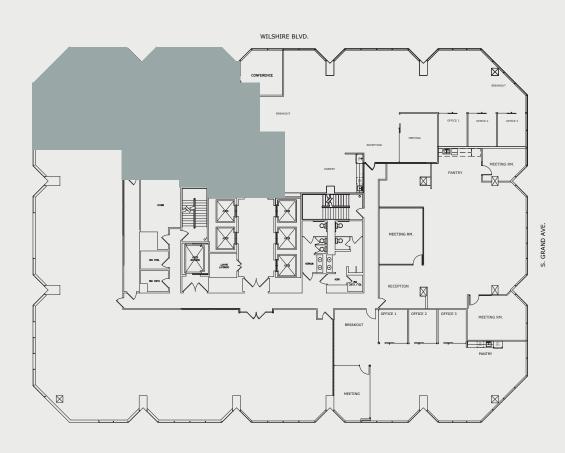

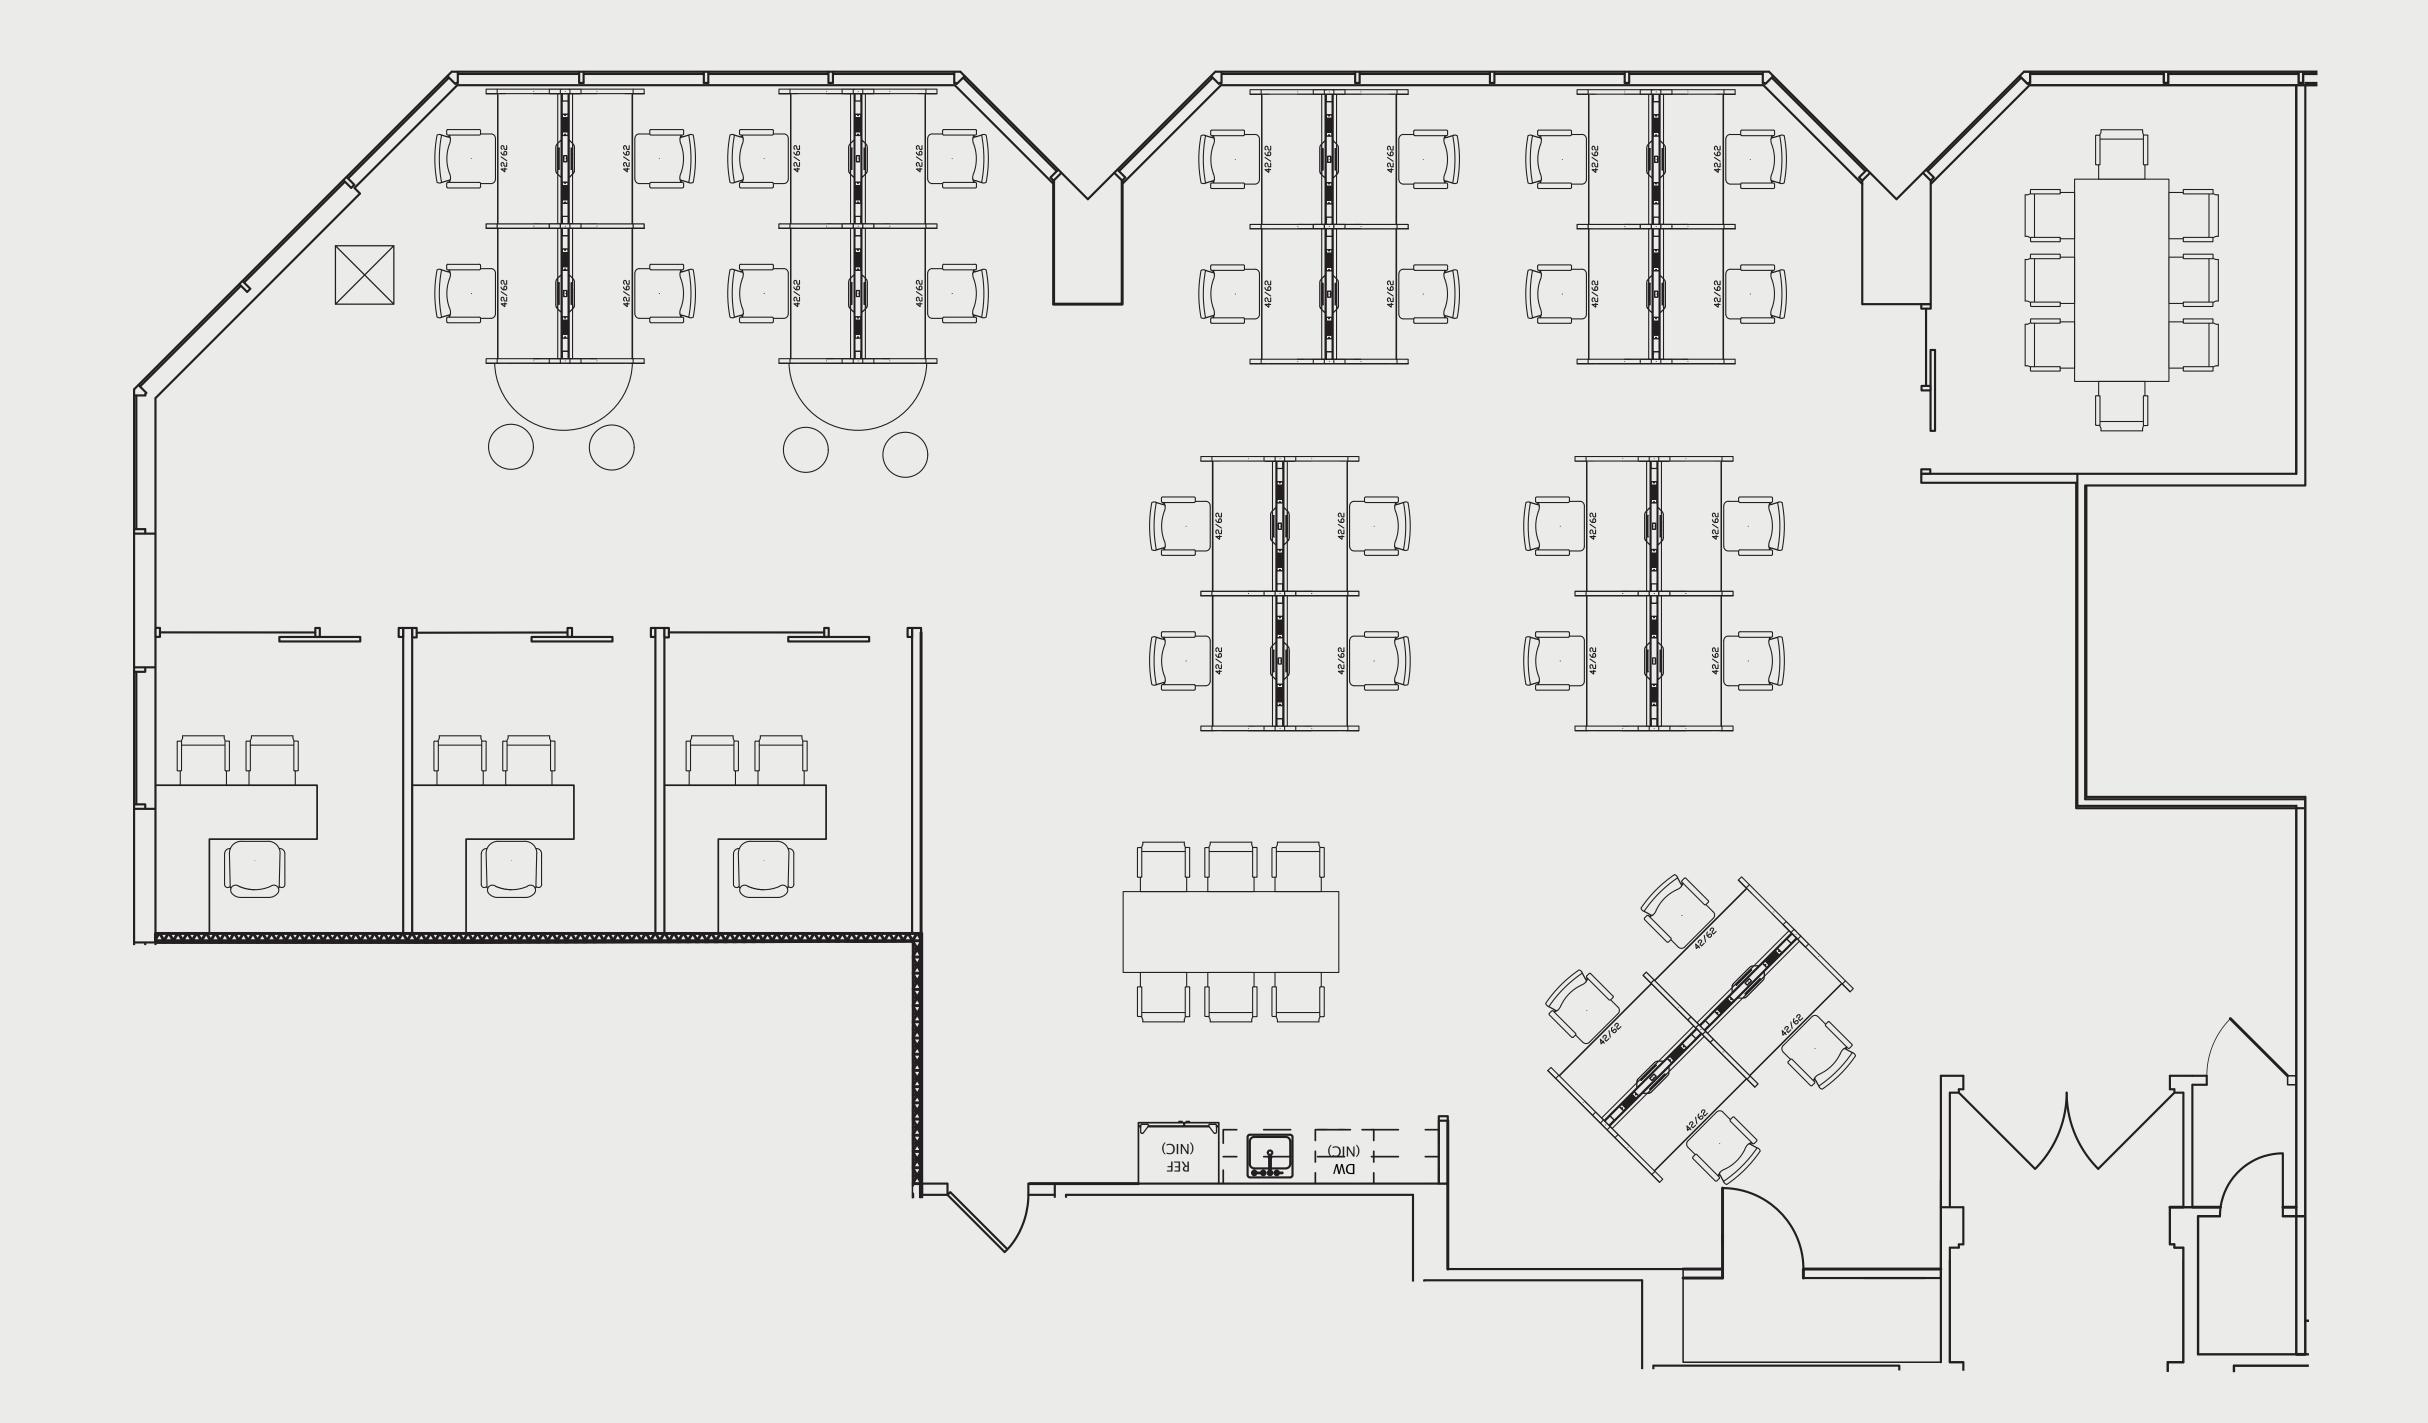

For leasing information please contact: USALEASING@ONNI.COM (213) 629-2041



