
## RSF: 8,548 SUITE: 1500/1540


## **AS-BUILT CONFIGURATION**

PRIVATE OFFICES	5
CONFERENCE ROOMS	2
KITCHEN	2
OPEN WORK AREA+/-4	7

**KEY PLAN:** 

Not to scale, furniture and appliances not included

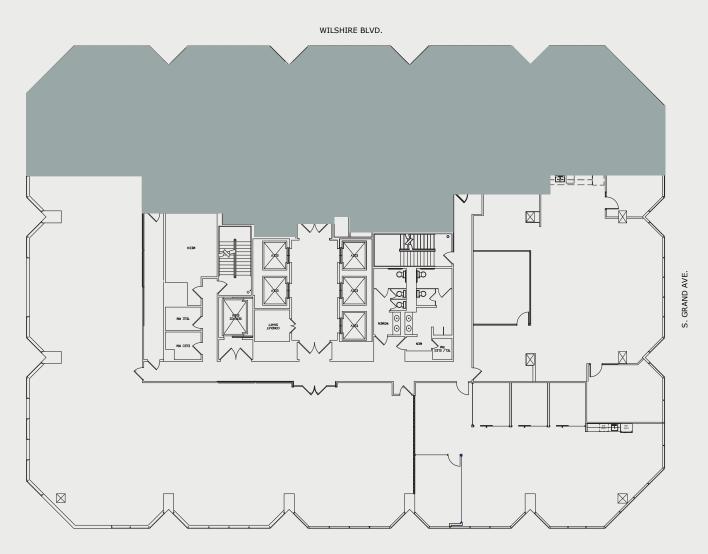

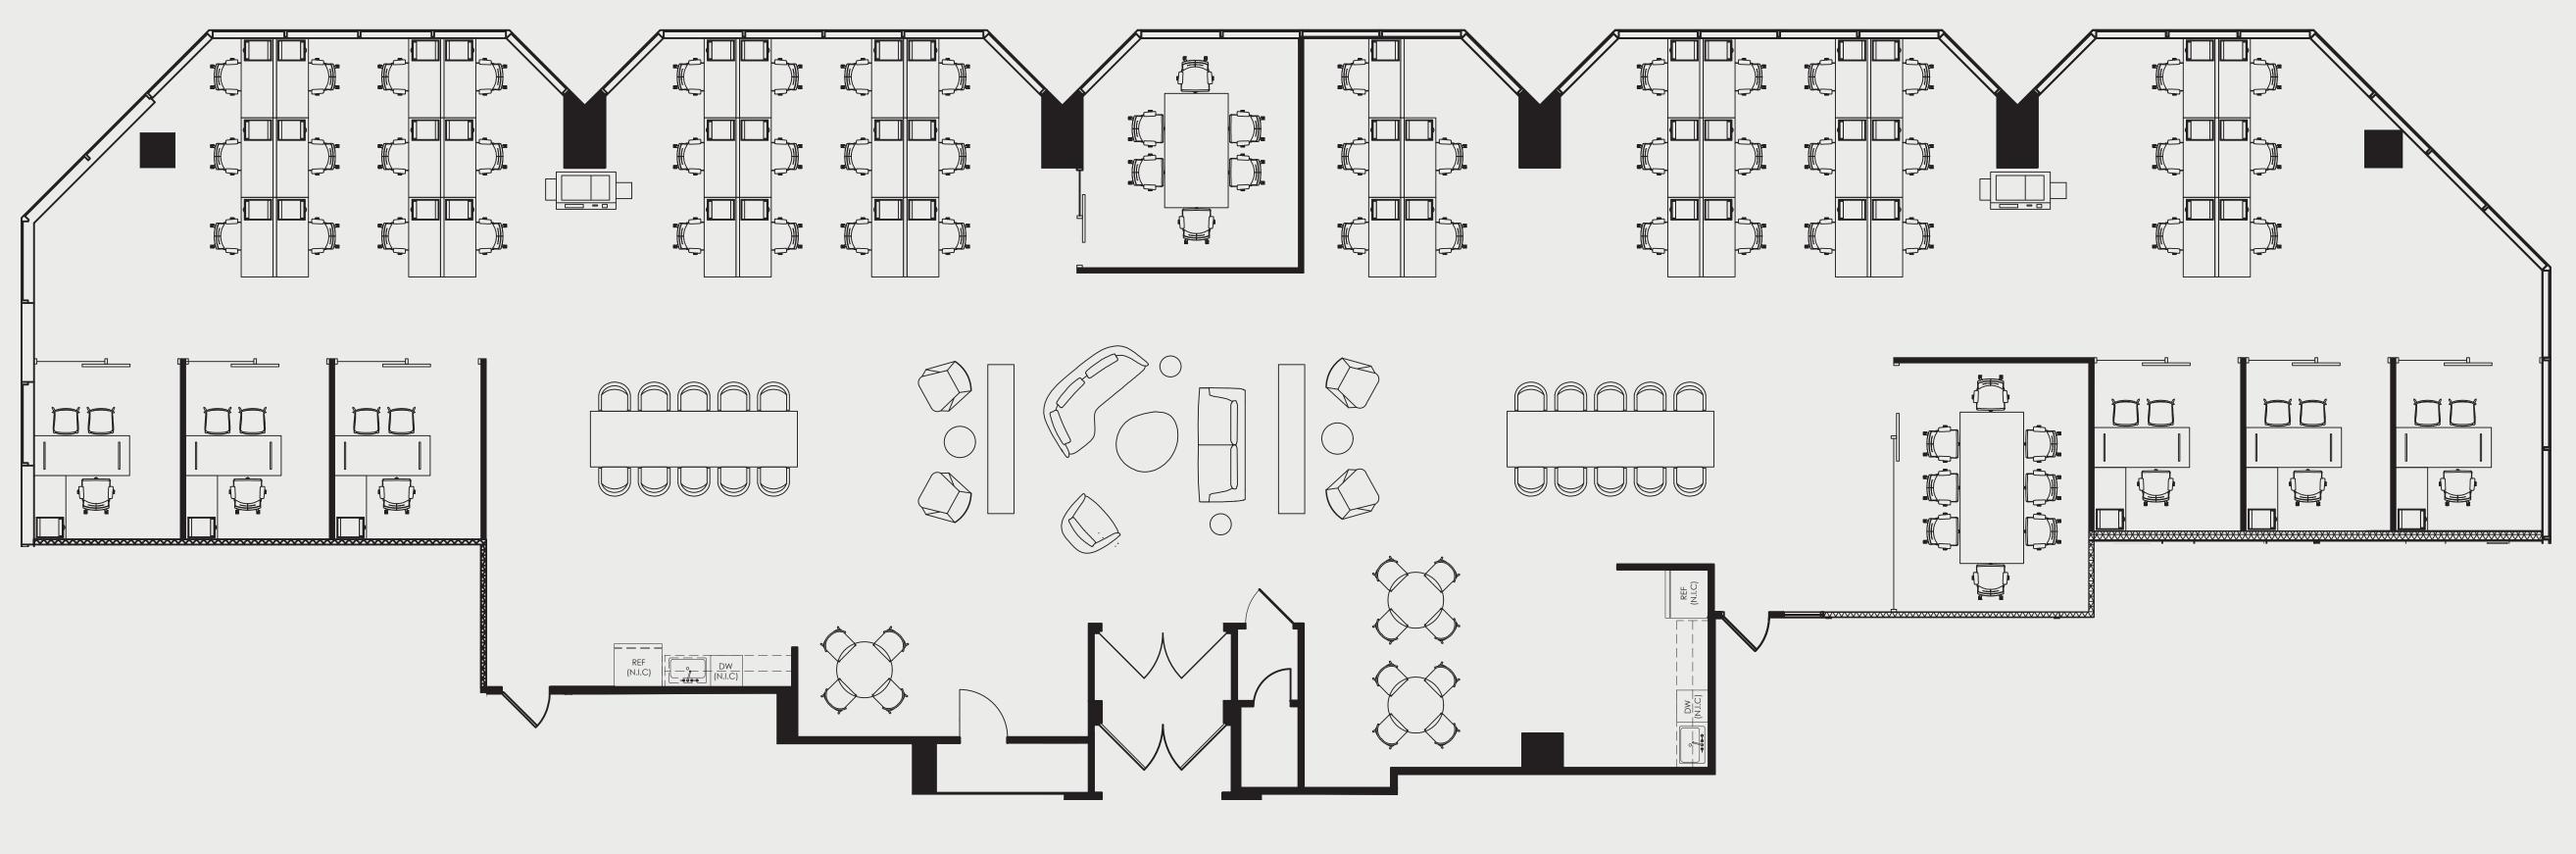

For leasing information please contact: USALEASING@ONNI.COM



