

SUITE: 1515



RSF: 3,662



AS-BUILT CONFIGURATION

- OFFICES..... 3
- RECEPTION..... 1
- CONFERENCE ROOMS.....1
- KITCHEN..... 1
- OPEN WORK AREA..... +/- 28

KEY PLAN:
Not to scale, furniture and appliances not included

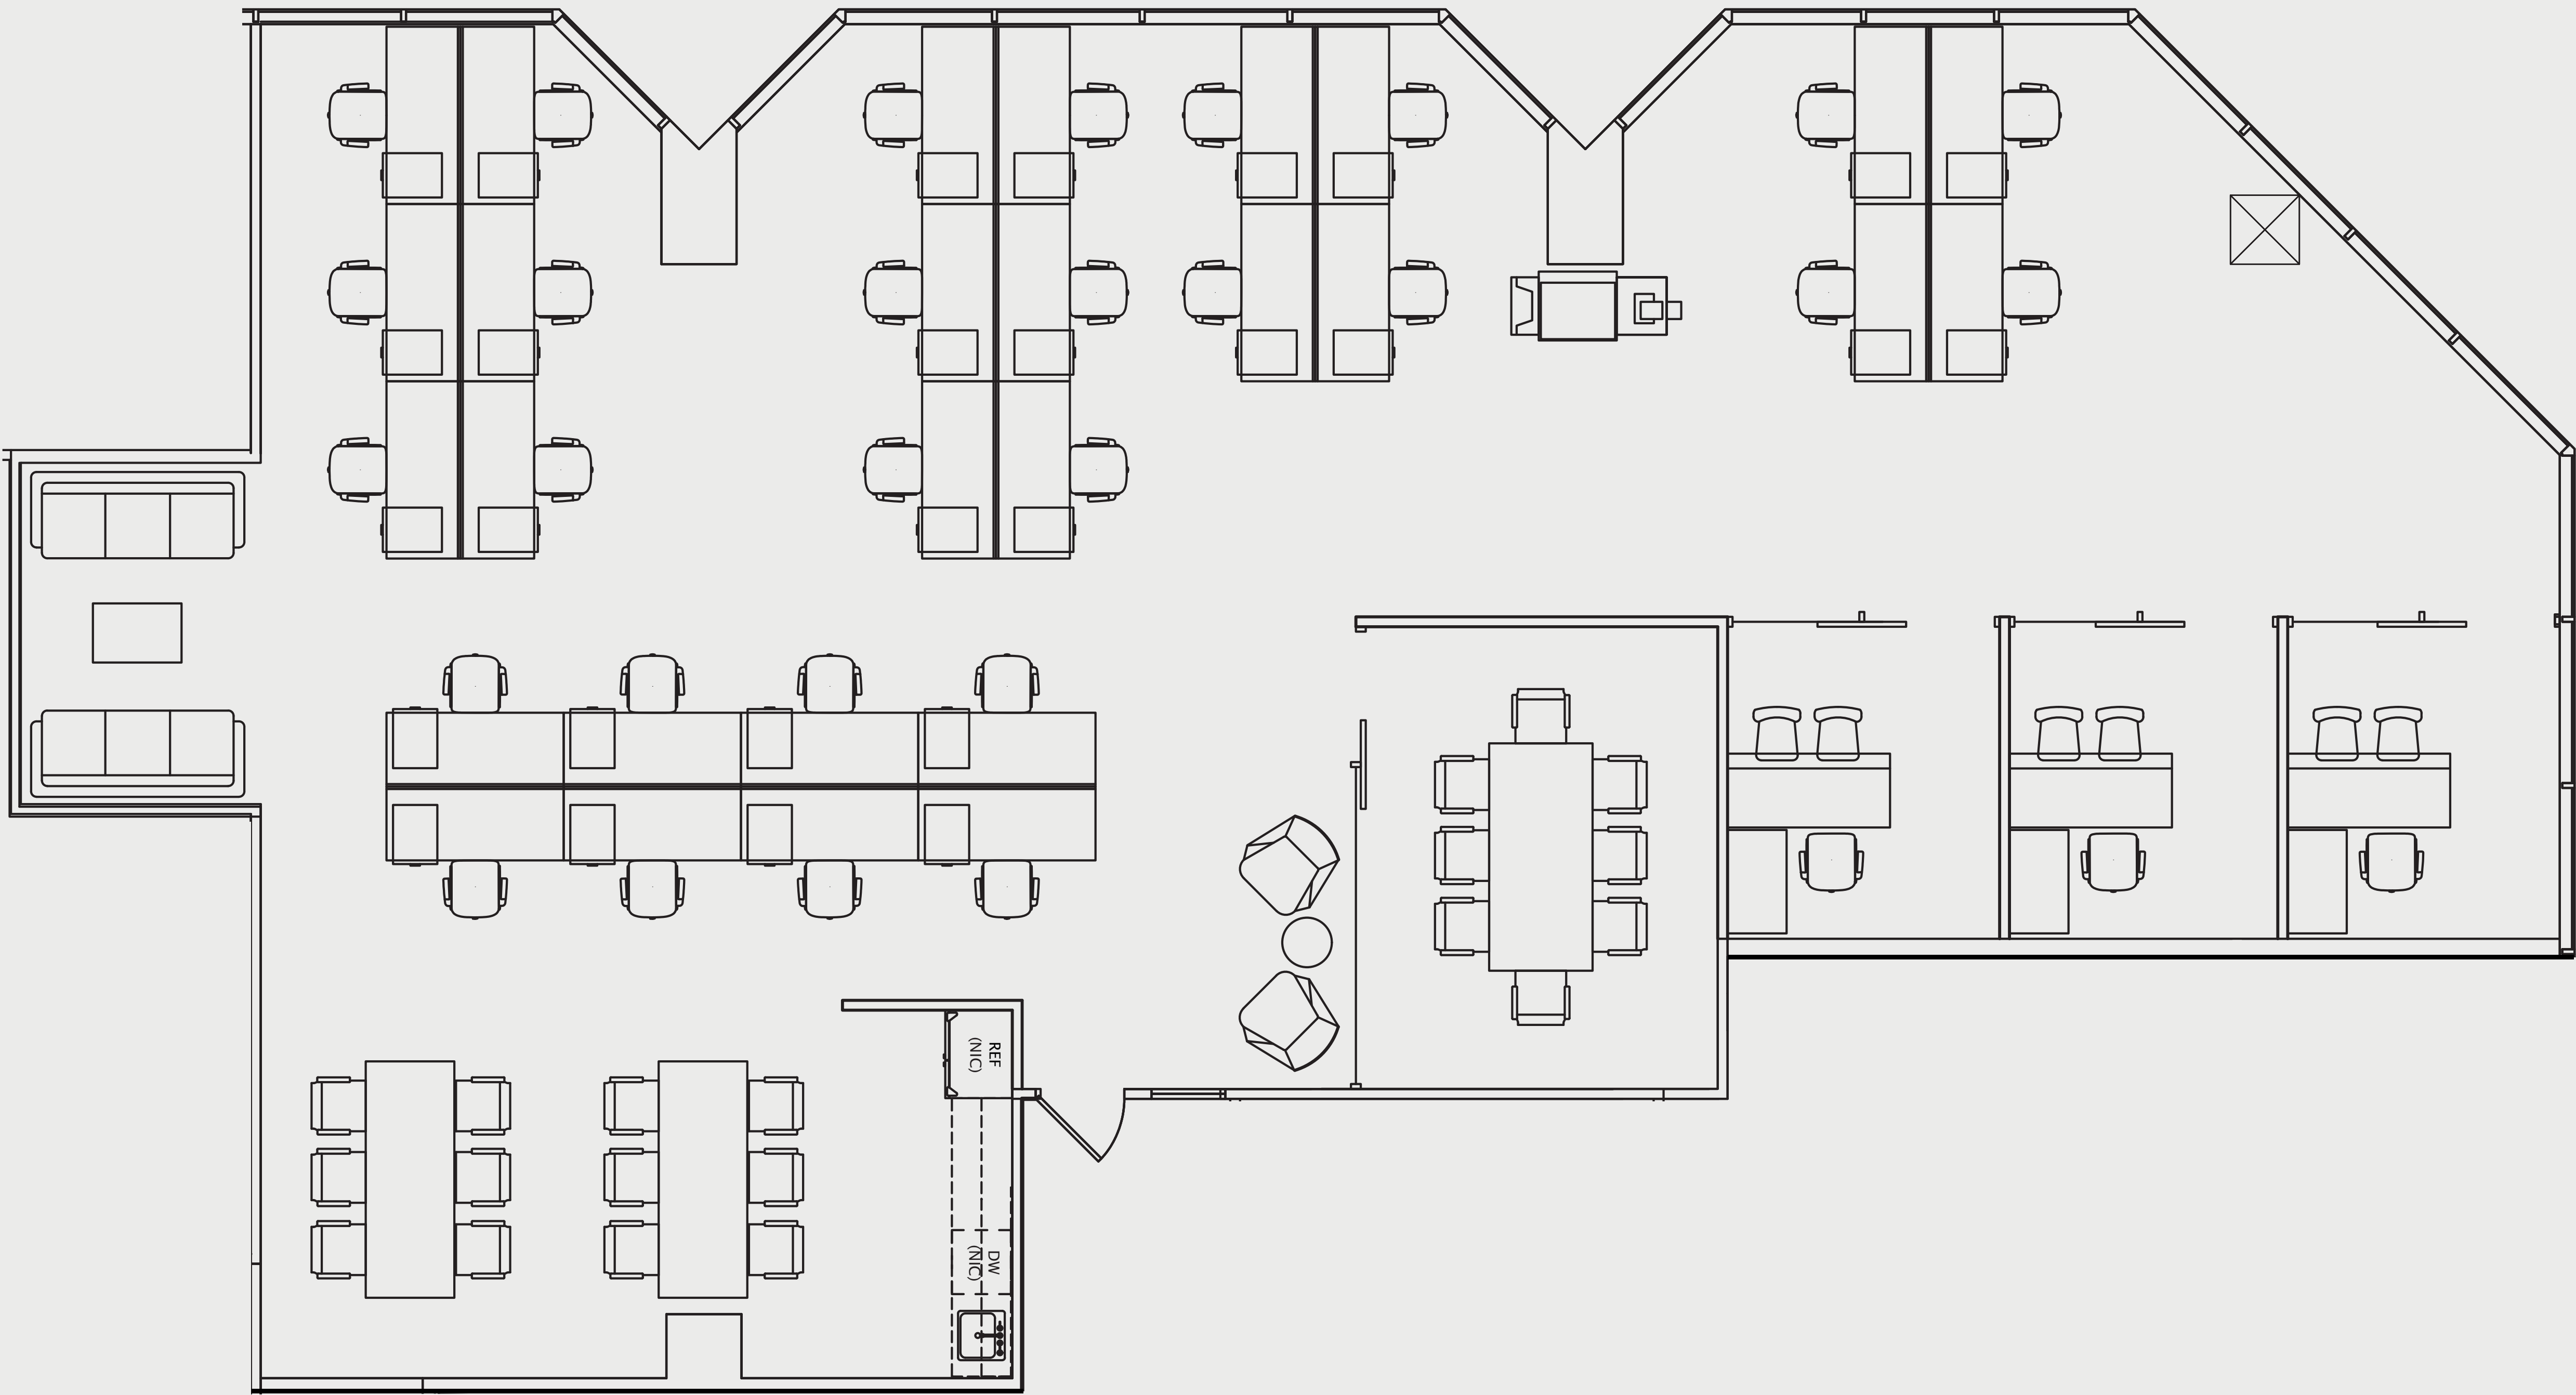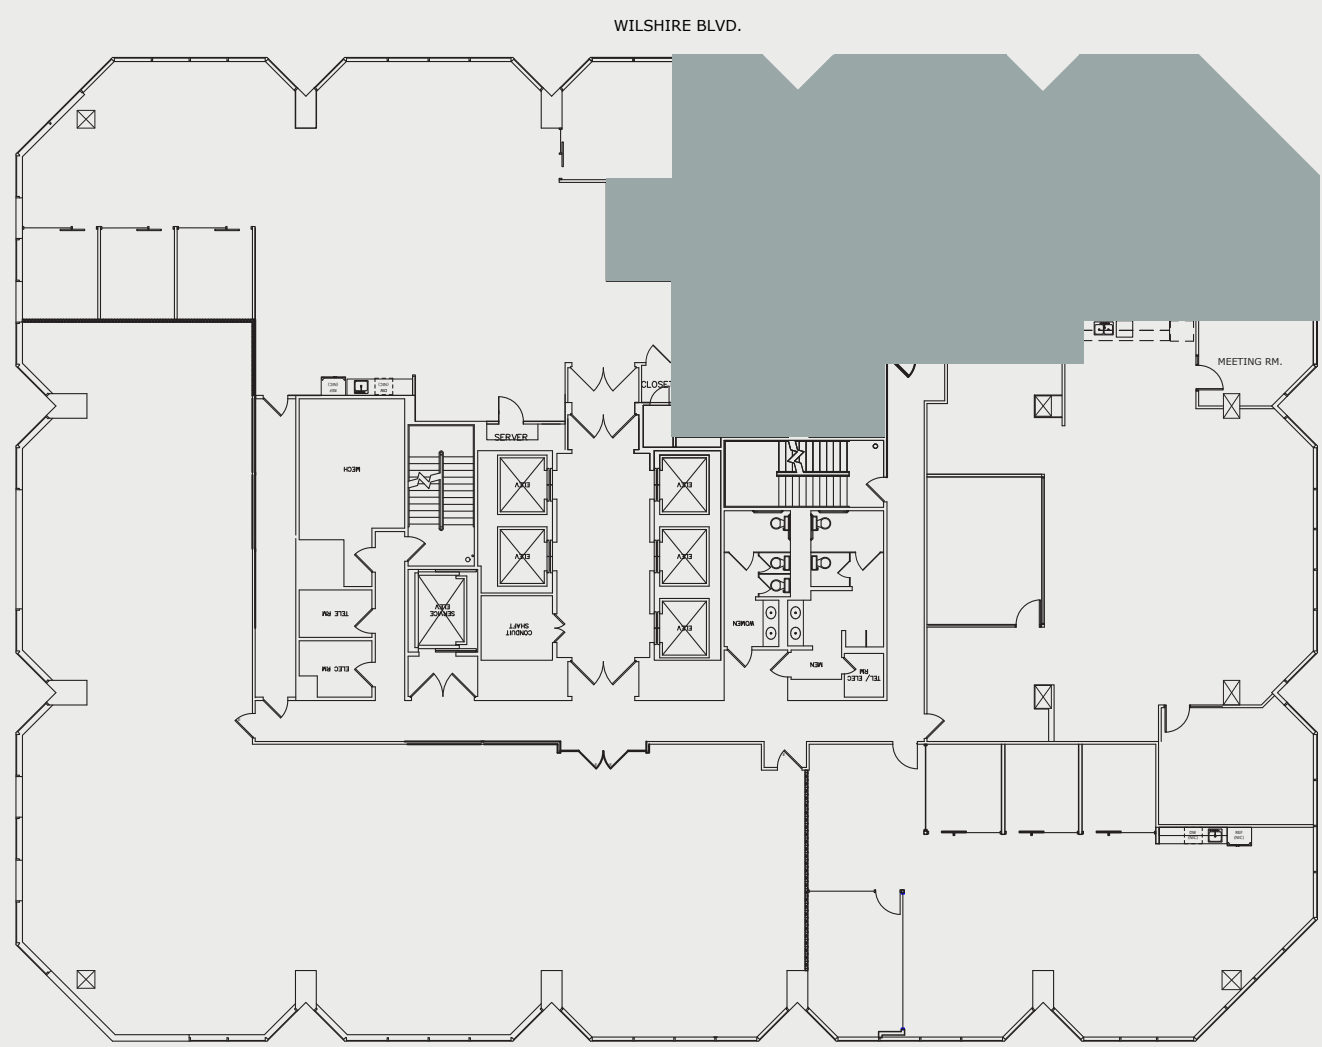

For leasing information please contact:
USALEASING@ONNI.COM
(213) 629-2041

