



# SUITE: 1540    RSF: 2,337

## AS-BUILT CONFIGURATION

- PRIVATE OFFICES.....3
- RECEPTION.....1
- CONFERENCE ROOMS.....1
- KITCHEN.....1
- OPEN WORK AREA.....+/-12

### KEY PLAN:

*Not to scale, furniture and appliances not included*

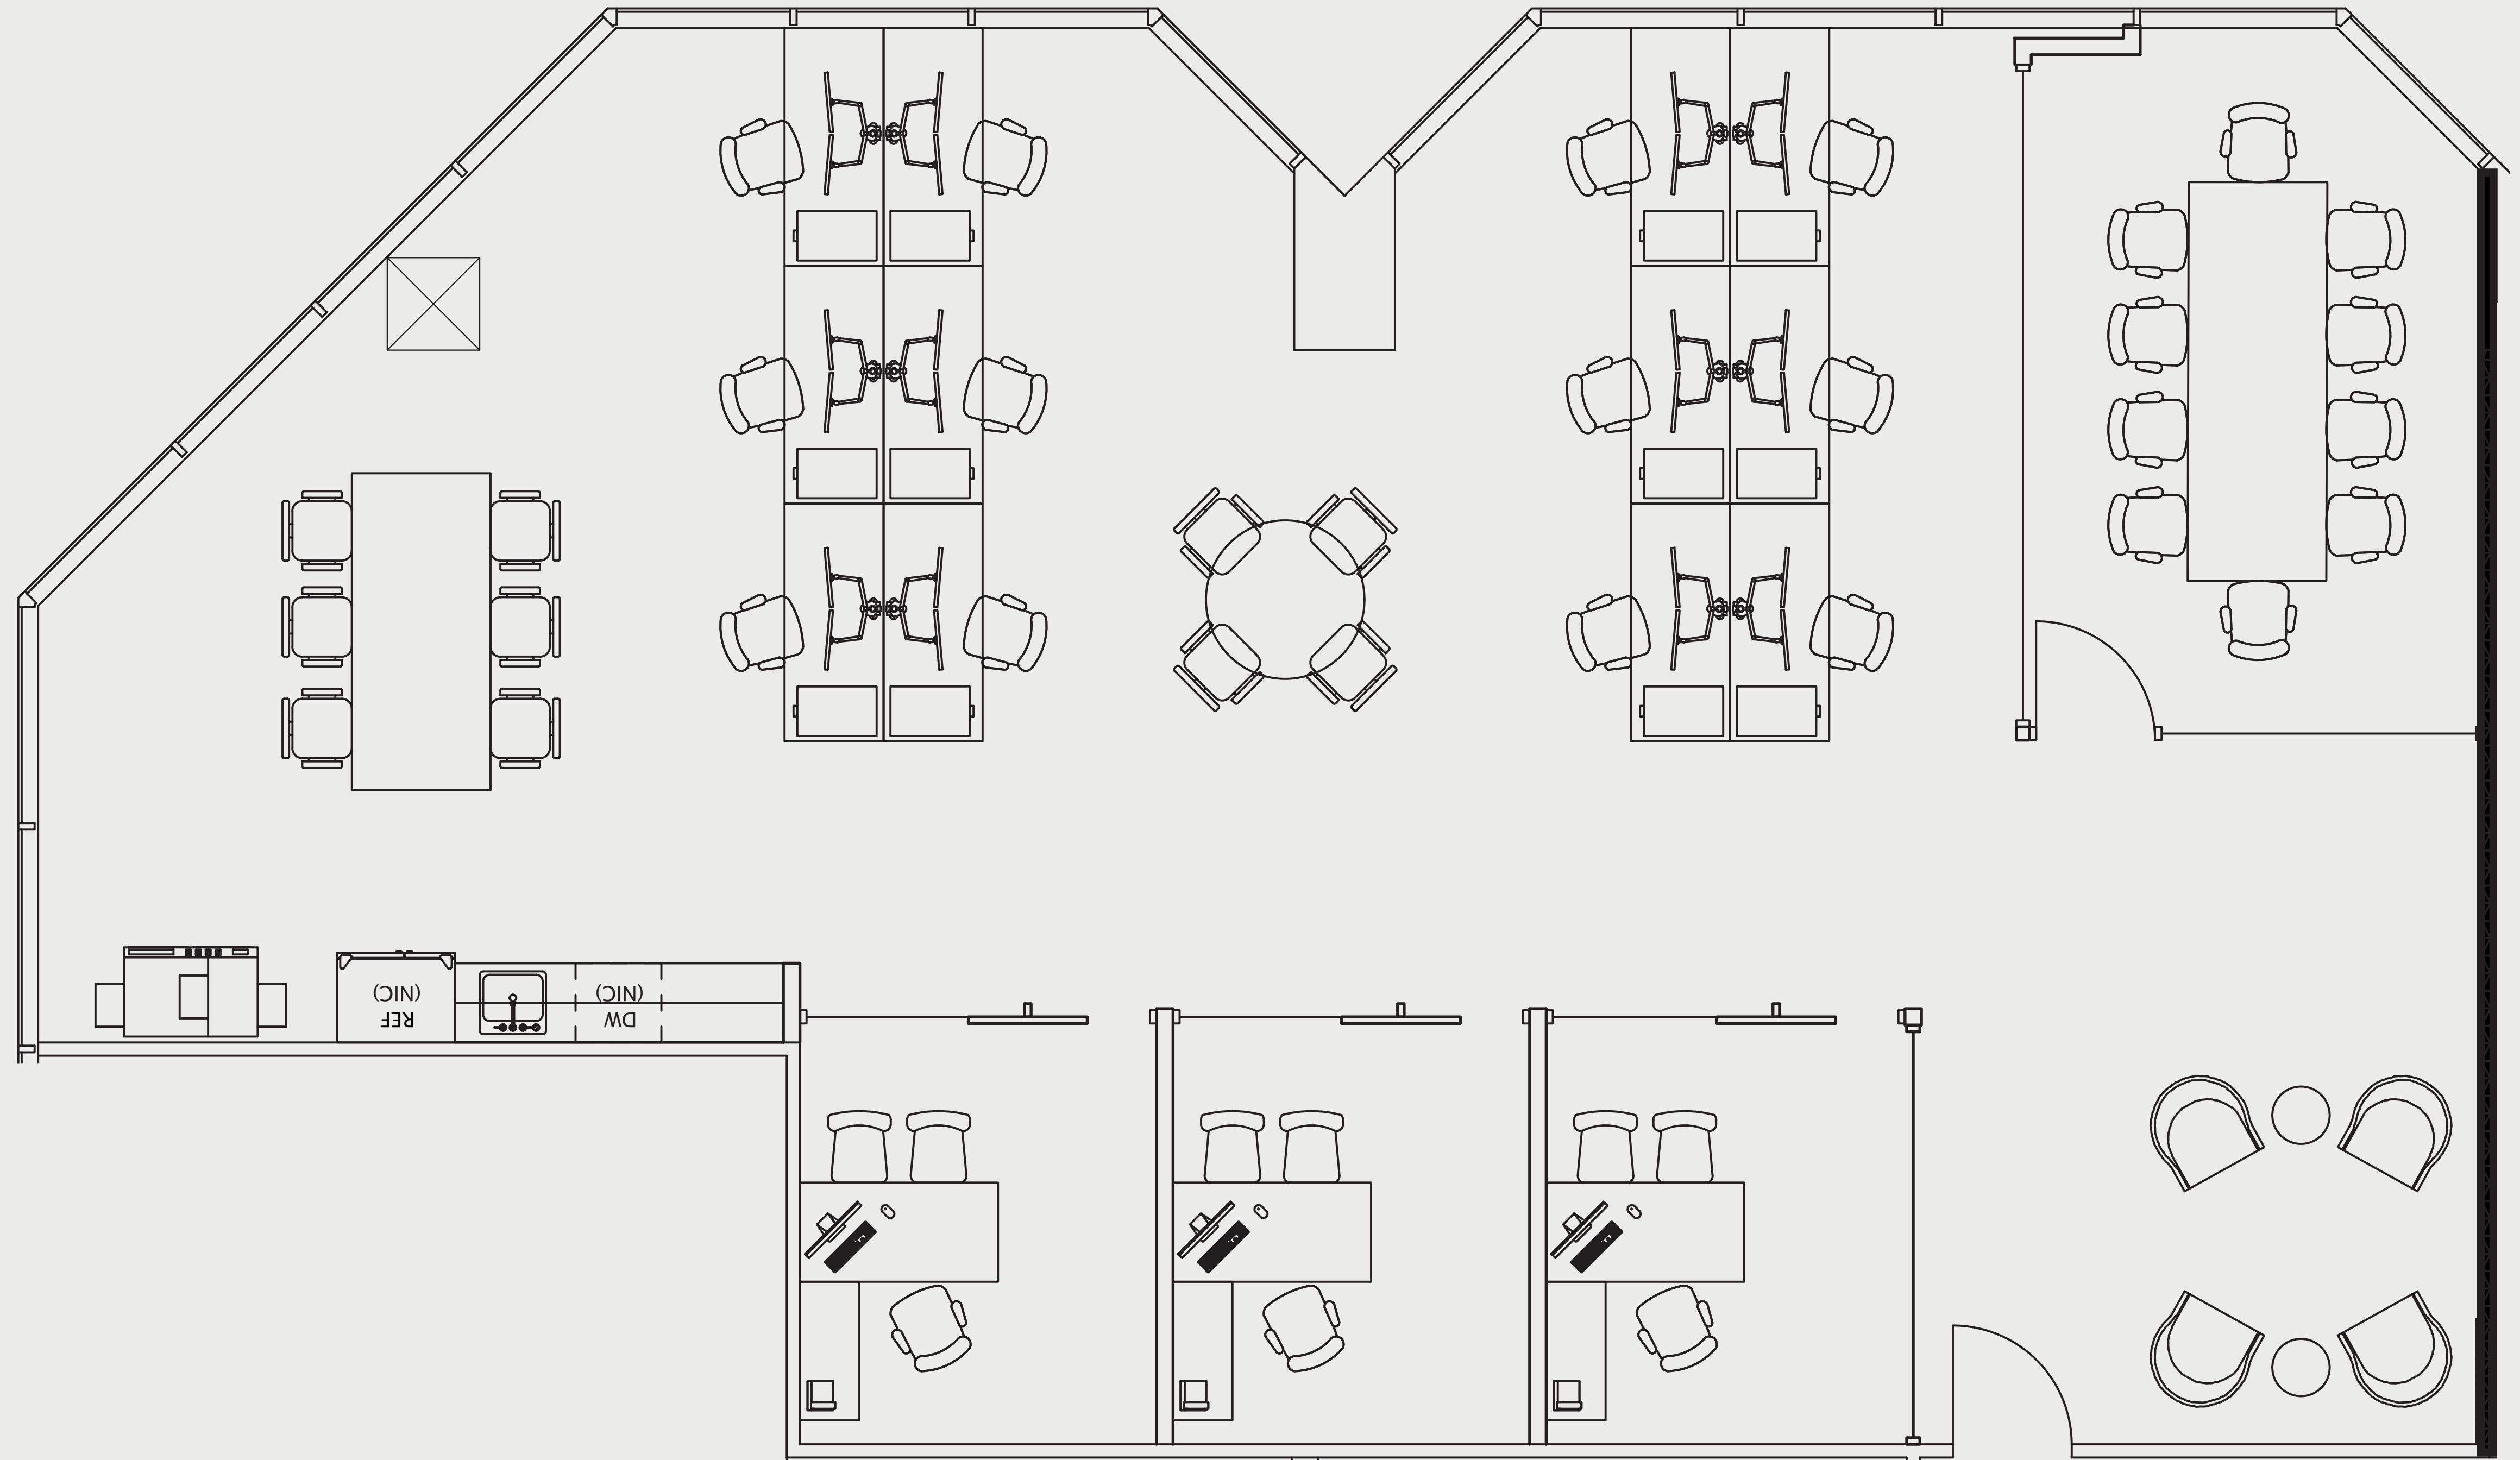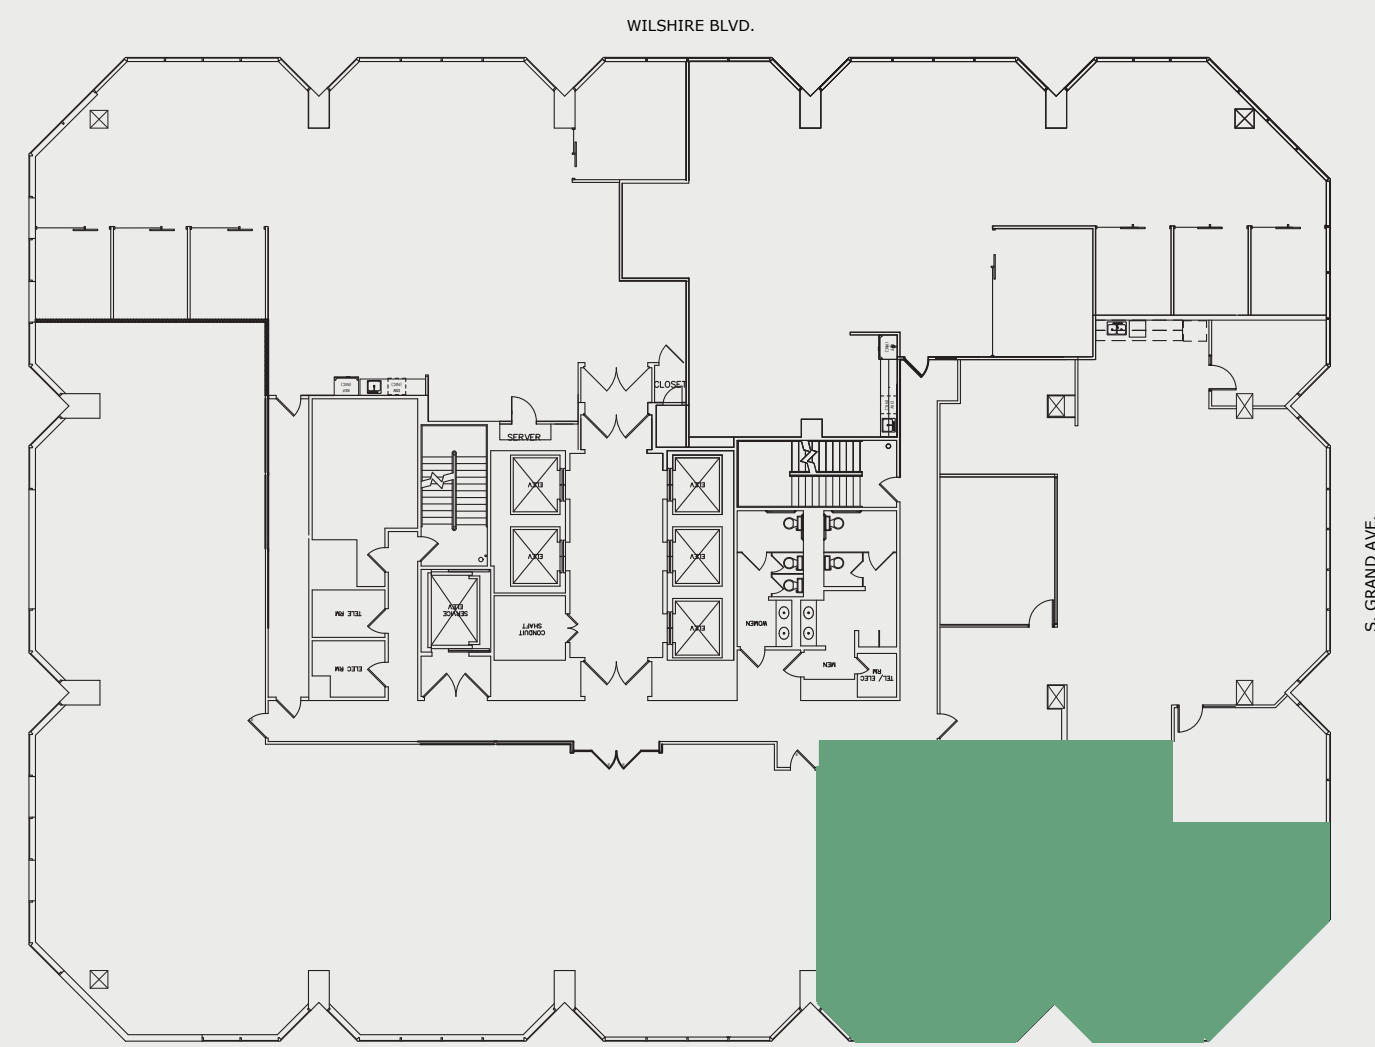

For leasing information please contact:  
[USA@LEASING@ONNI.COM](mailto:USA@LEASING@ONNI.COM)  
 (213) 629-2041