

SUITE: 1540



RSF: 2,337

AS-BUILT CONFIGURATION

- OFFICES..... 3
- RECEPTION..... 1
- CONFERENCE ROOMS.....1
- KITCHEN..... 1
- OPEN WORK AREA..... +/- 12

KEY PLAN:

Not to scale, furniture and appliances not included

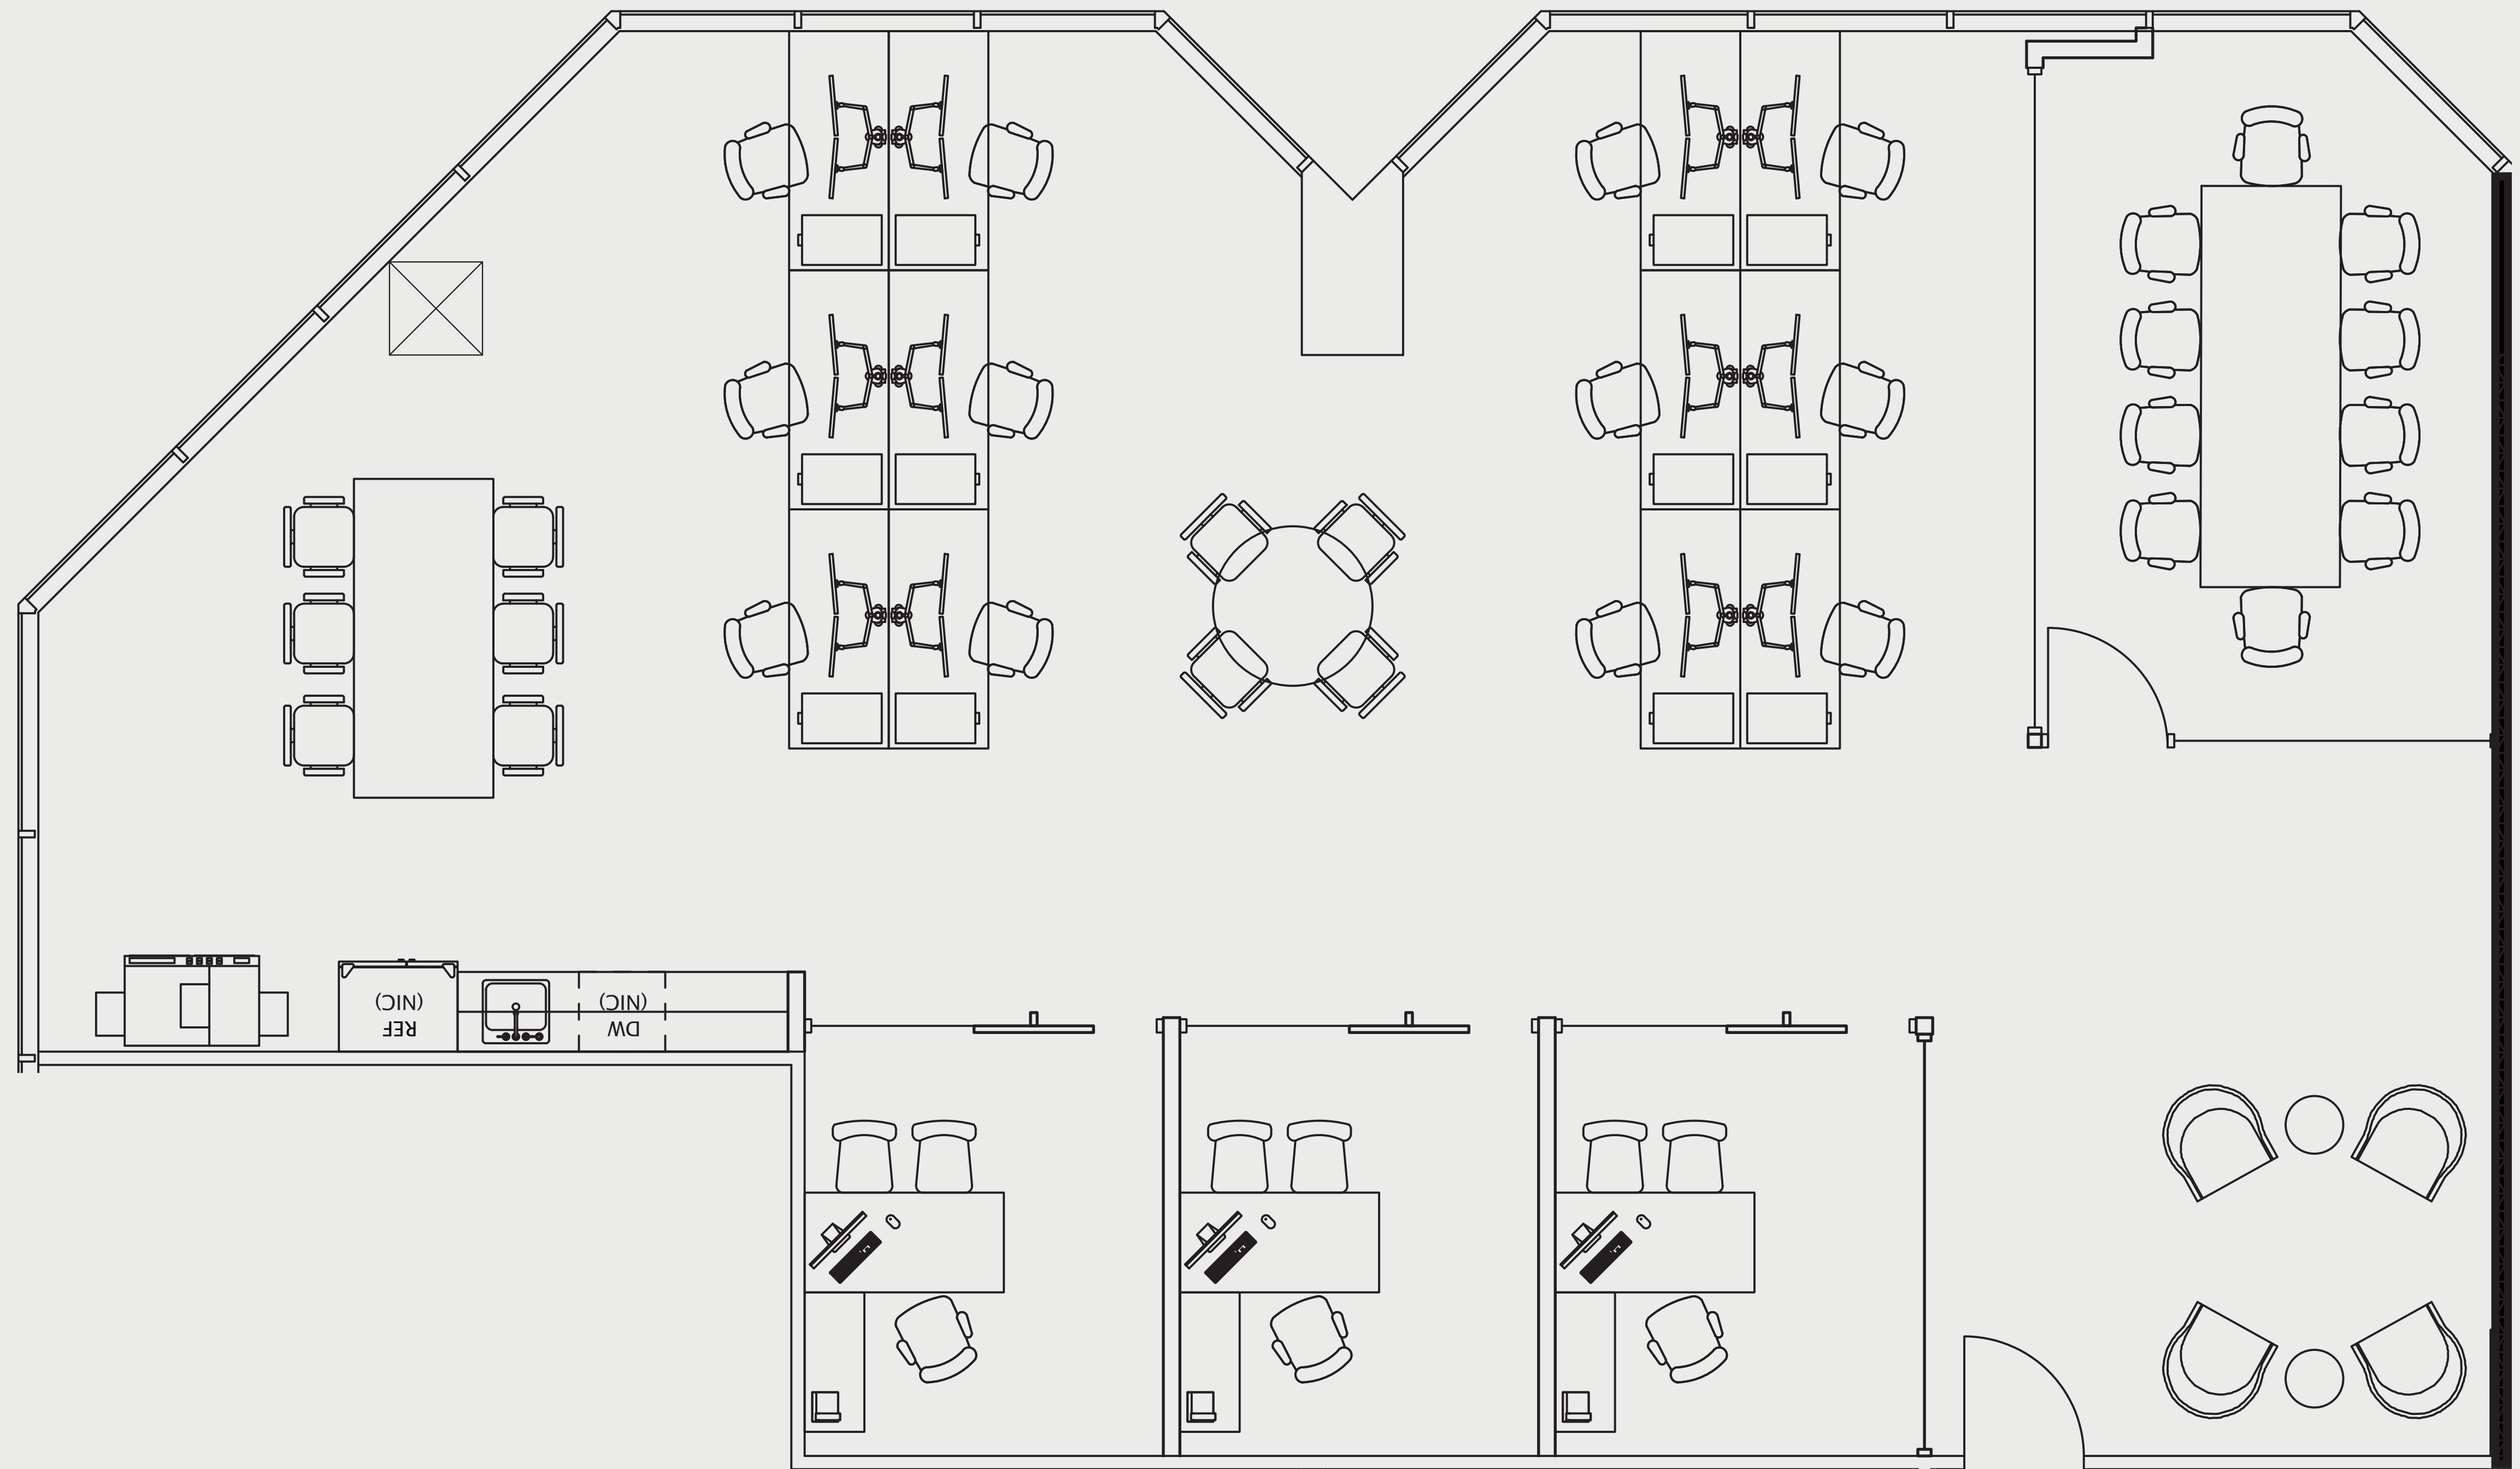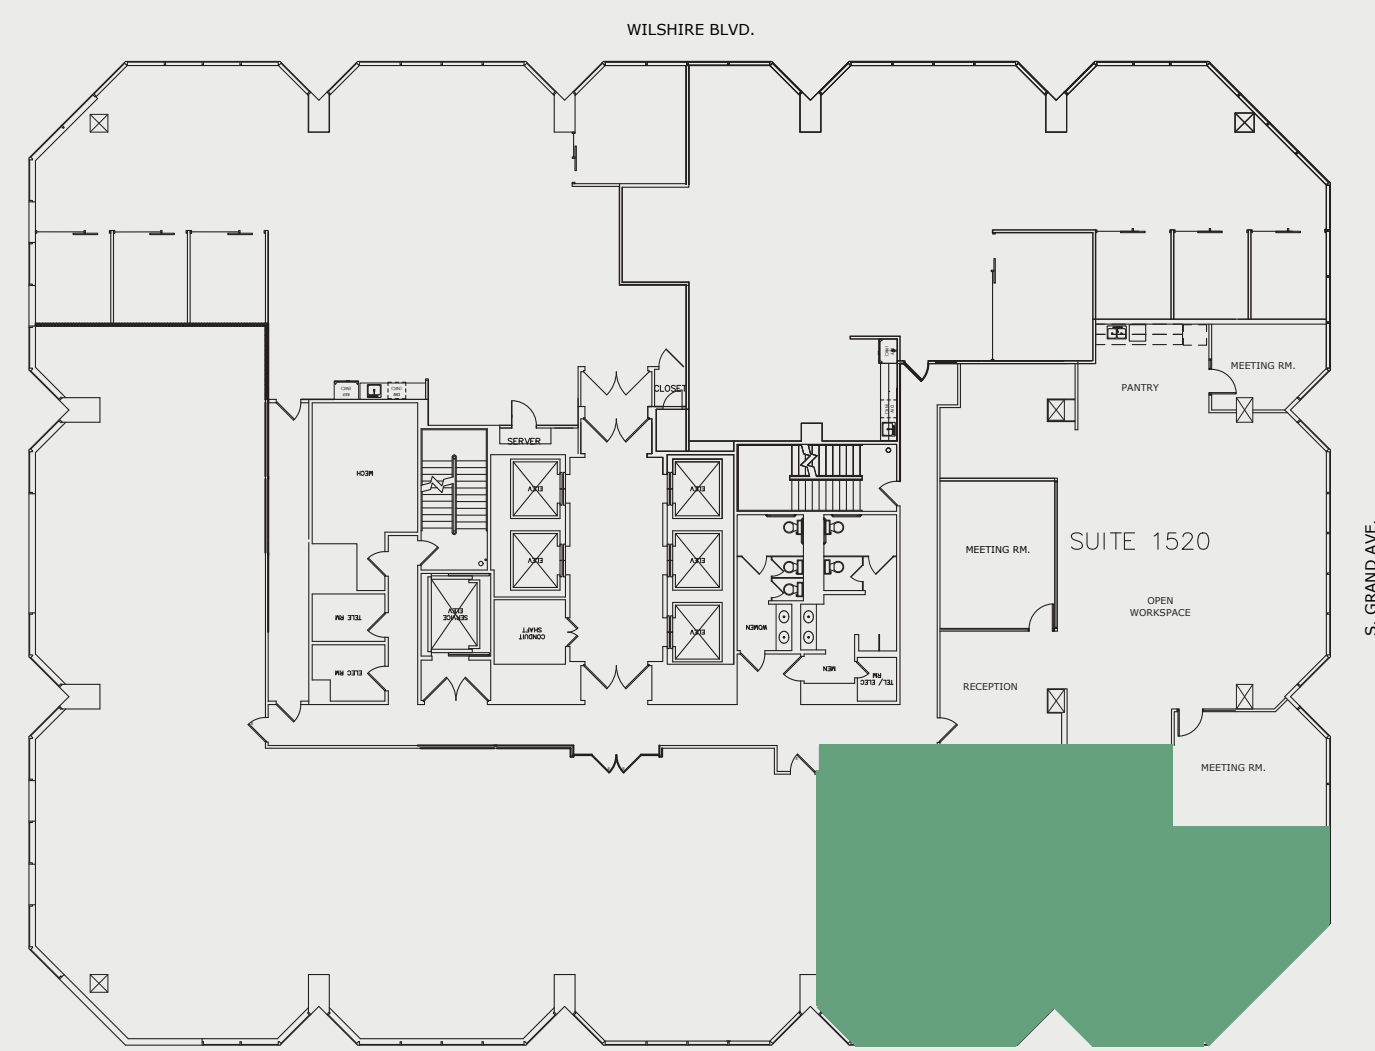

For leasing information please contact:
Andrew Tashjian
213.955.5148 andrew.tashjian@cushwake.com