


SUITE: 1600

RSF: 4,716




AS-BUILT CONFIGURATION

- PRIVATE OFFICES.....4
- SHARED OFFICES.....2
- CONFERENCE ROOMS.....2
- KITCHEN.....1

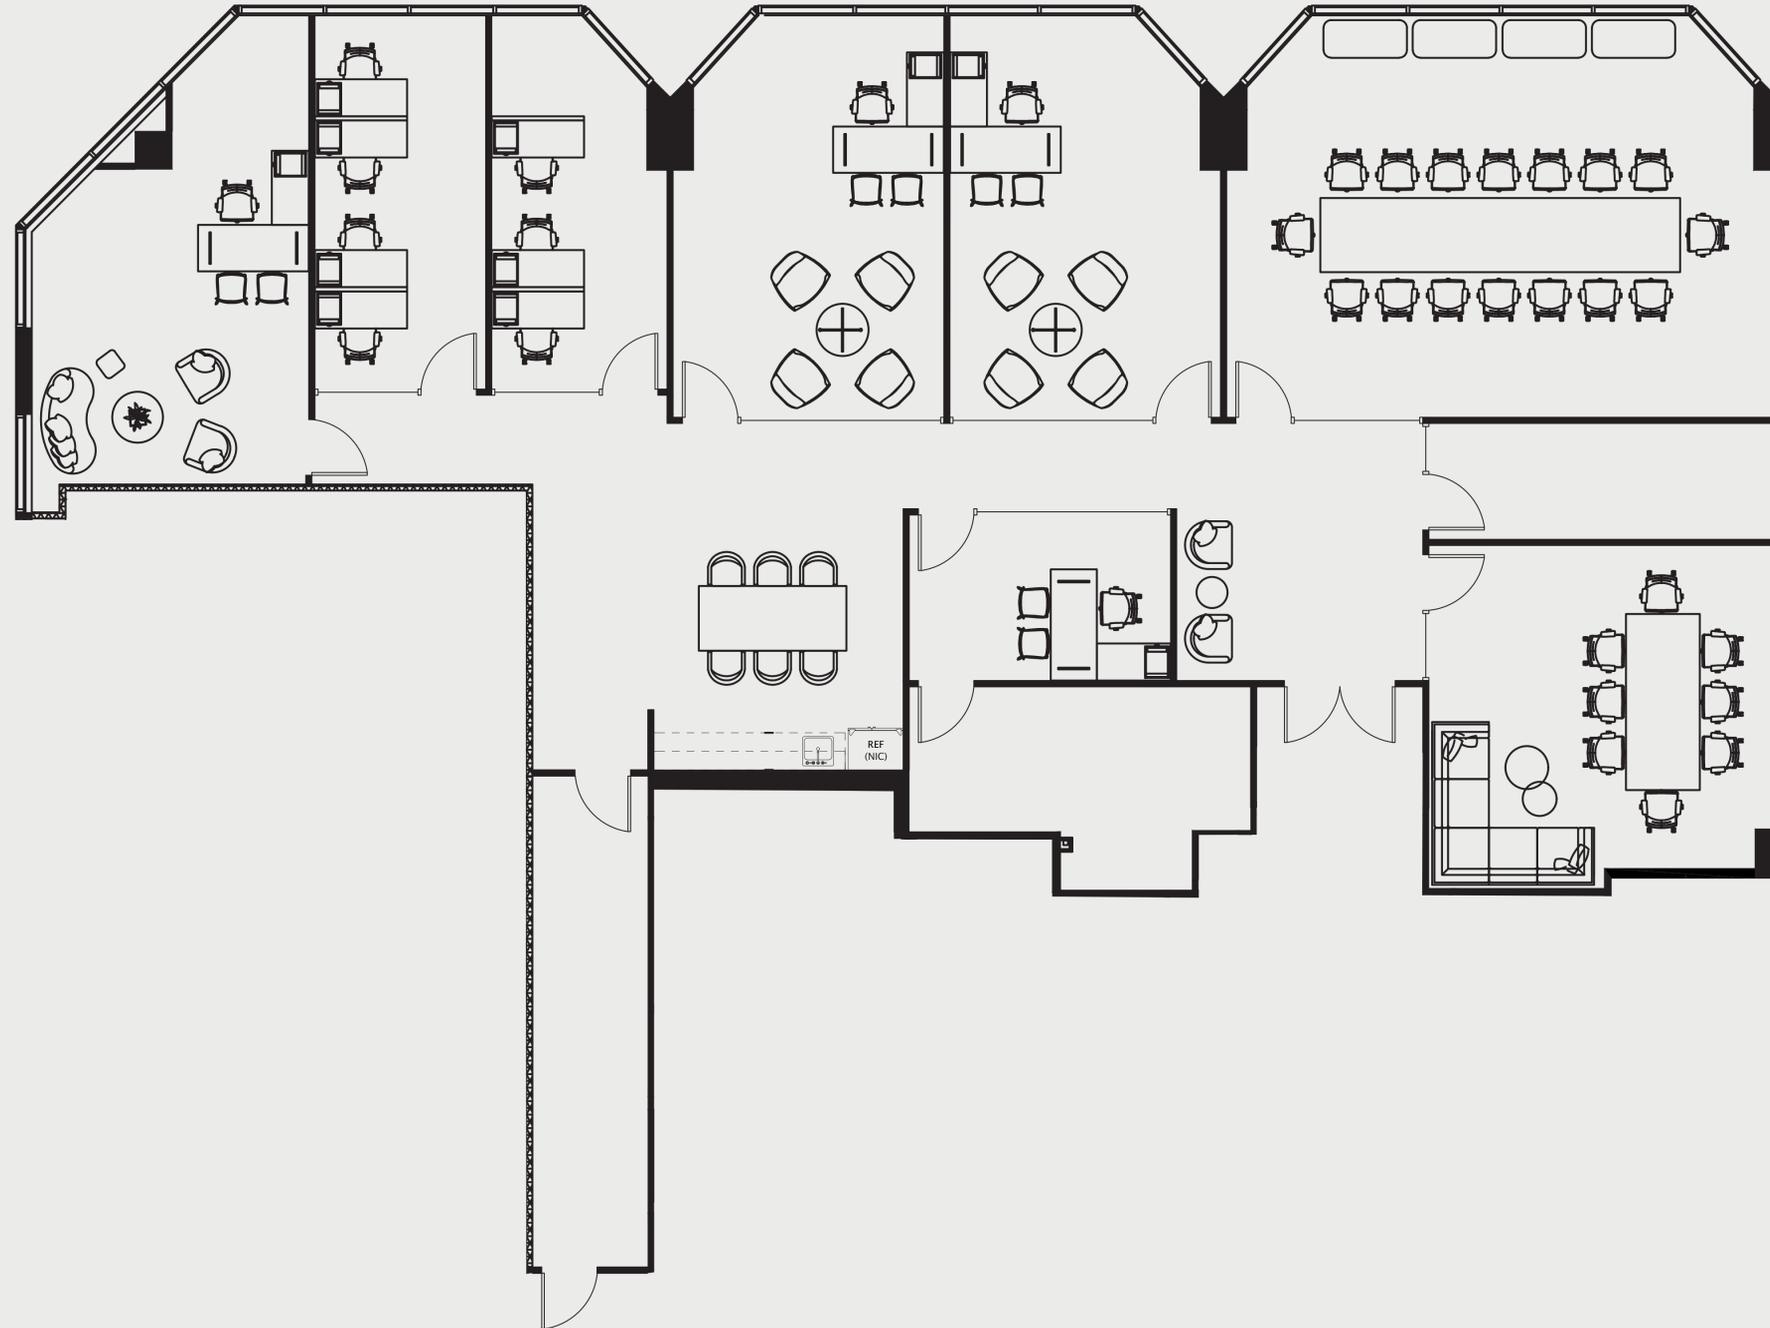

KEY PLAN:

Not to scale, furniture and appliances not included

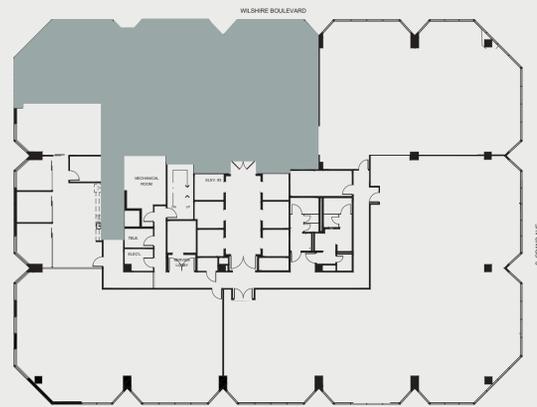

For leasing information please contact:
USALEASING@ONNI.COM
(213) 629-2041

