

SUITE: 1660

RSF: 3,194





AS-BUILT CONFIGURATION

- OFFICES..... 1
- RECEPTION..... 1
- CONFERENCE ROOMS..... 1
- KITCHEN..... 1
- OPEN WORK AREA..... +/-19

KEY PLAN:

Not to scale, furniture and appliances not included

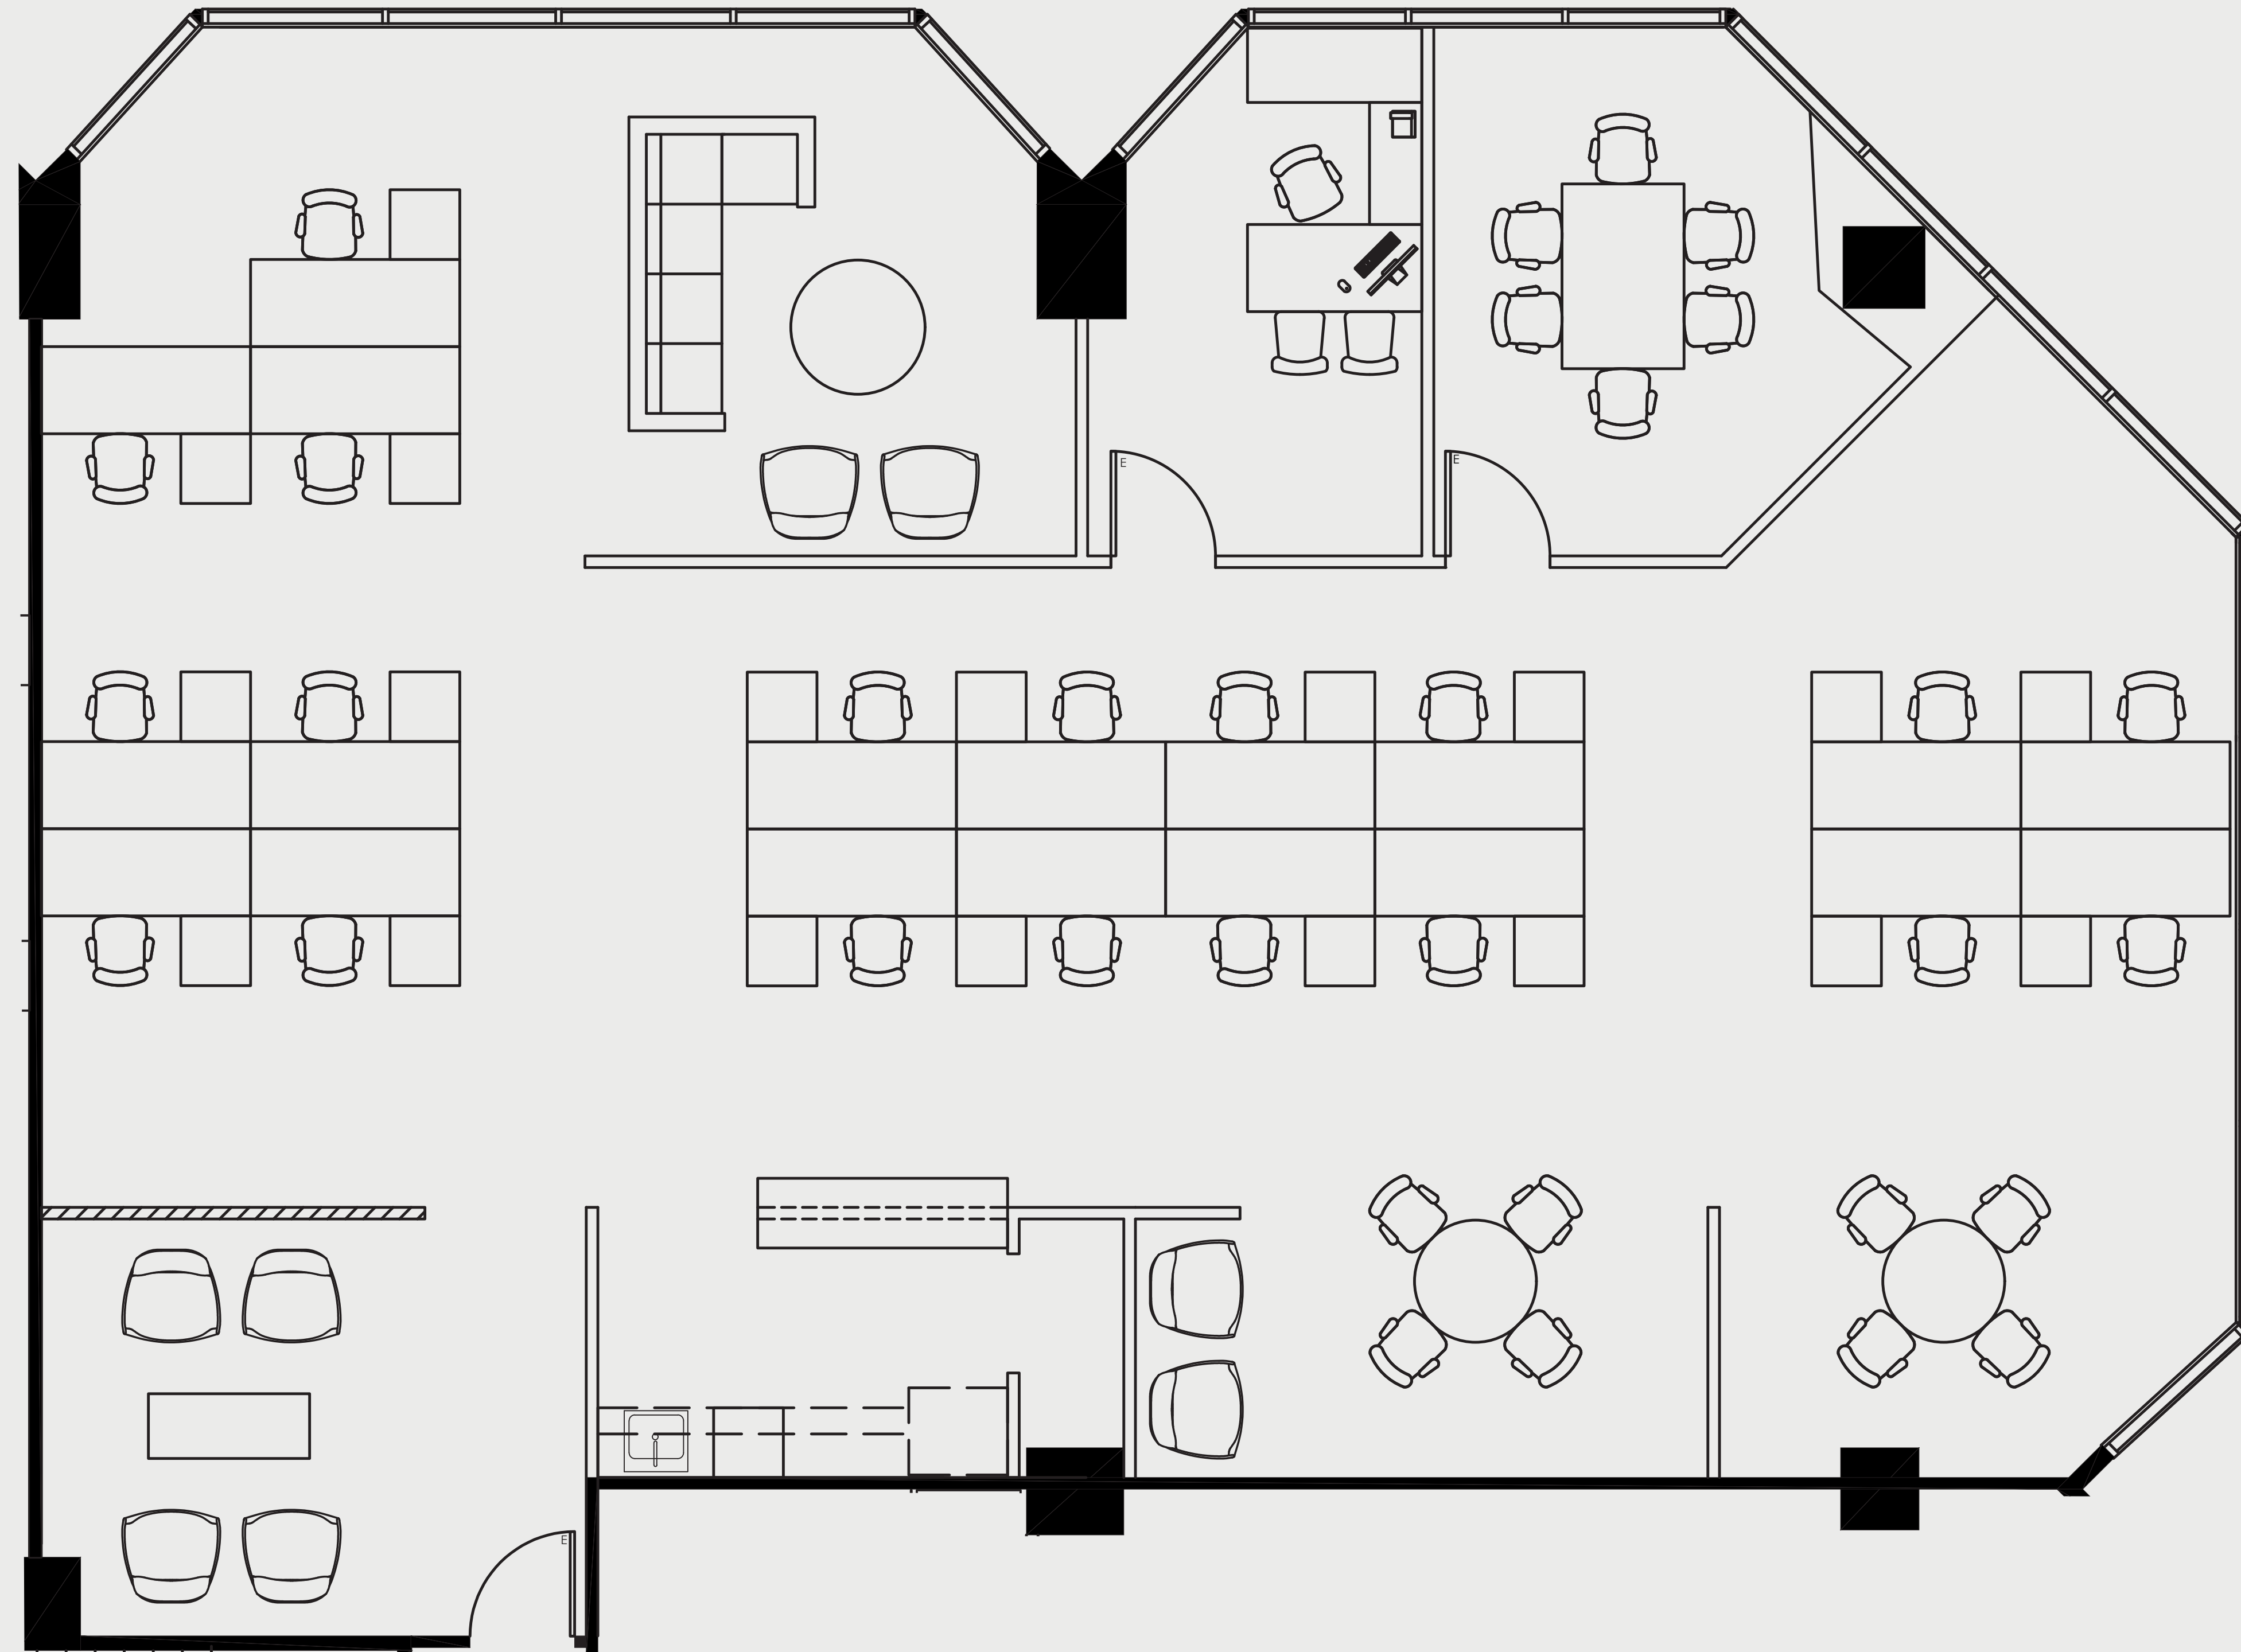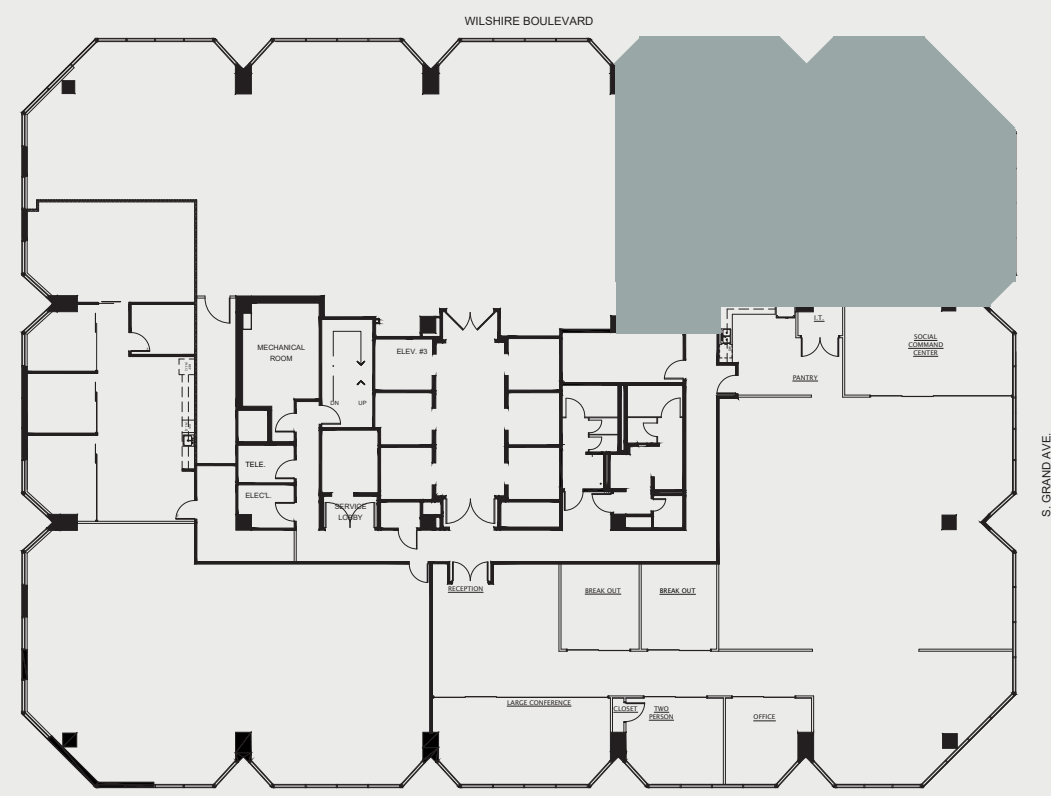

For leasing information please contact:
Nico Vilgate
213.532.3236 | nico.vilgate@colliers.com

Nick Moscicki
213.861.3345 | nick.moscicki@colliers.com

