

SUITE: 1700

RSF: 10,796





AS-BUILT CONFIGURATION

- PRIVATE OFFICES.....4
- CONFERENCE ROOMS.....3
- PHONE ROOMS.....3
- STUDIO.....1
- KITCHEN.....1
- OPEN WORK AREA..... +/-27

KEY PLAN:

Not to scale, furniture and appliances not included

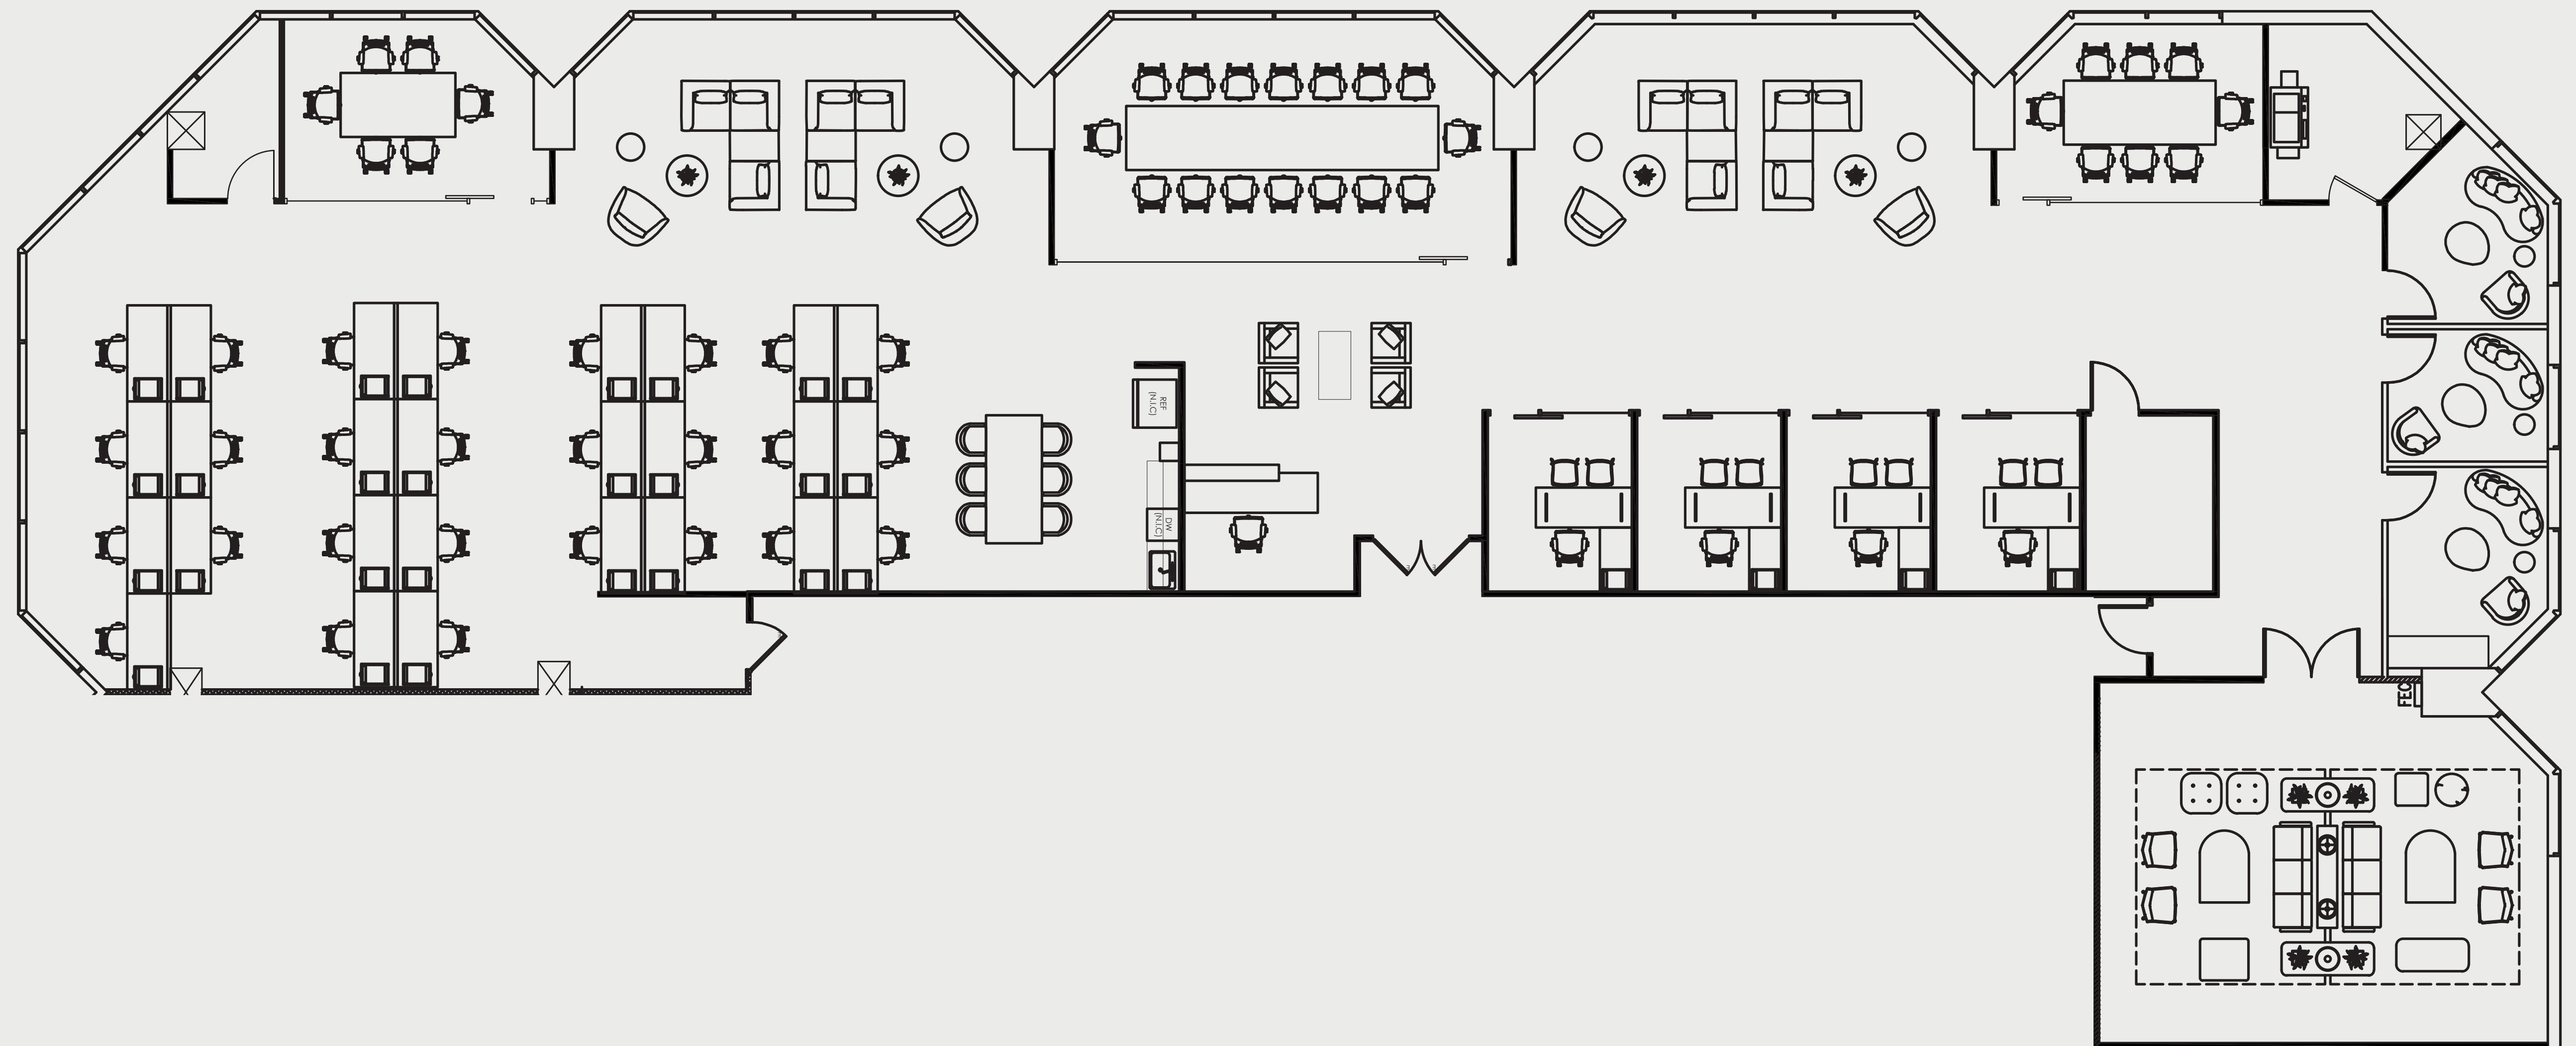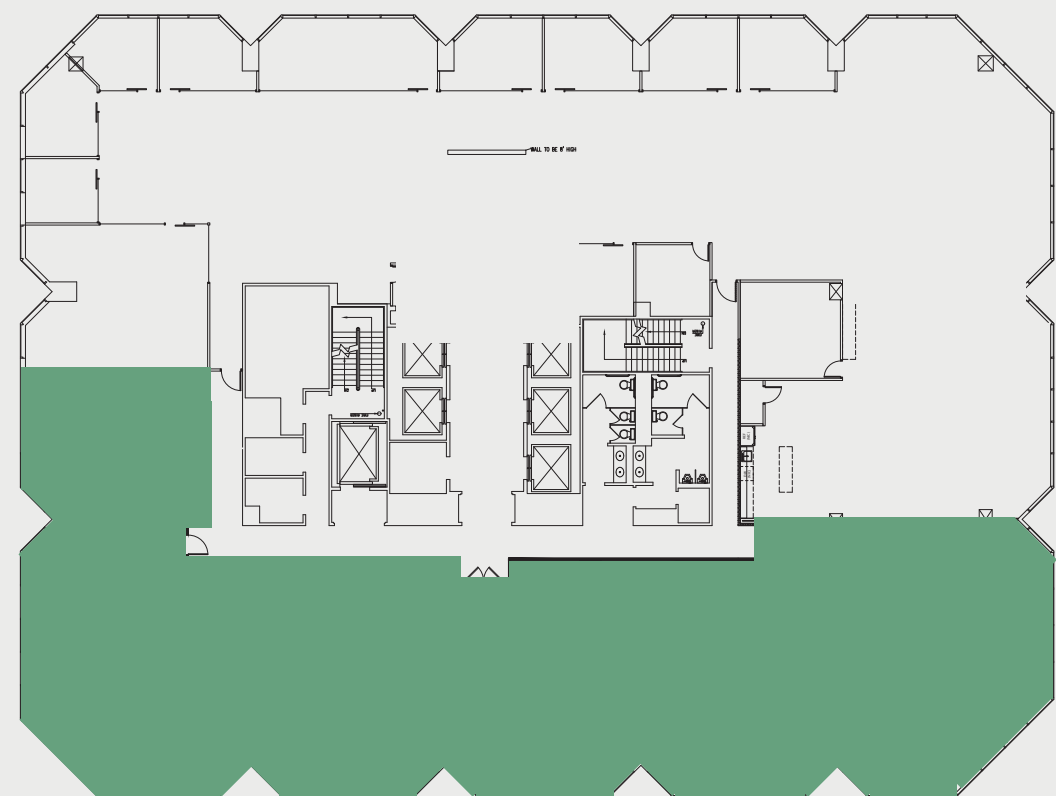

For leasing information please contact:
USALEASING@ONNI.COM
(213) 629-2041

