

SUITE: 1750

RSF: 10,804





AS-BUILT CONFIGURATION

- PRIVATE OFFICES.....8
- RECEPTION.....1
- CONFERENCE ROOMS.....3
- KITCHEN.....1
- OPEN ARE.....+/- 56

KEY PLAN:

Not to scale, furniture and appliances not included

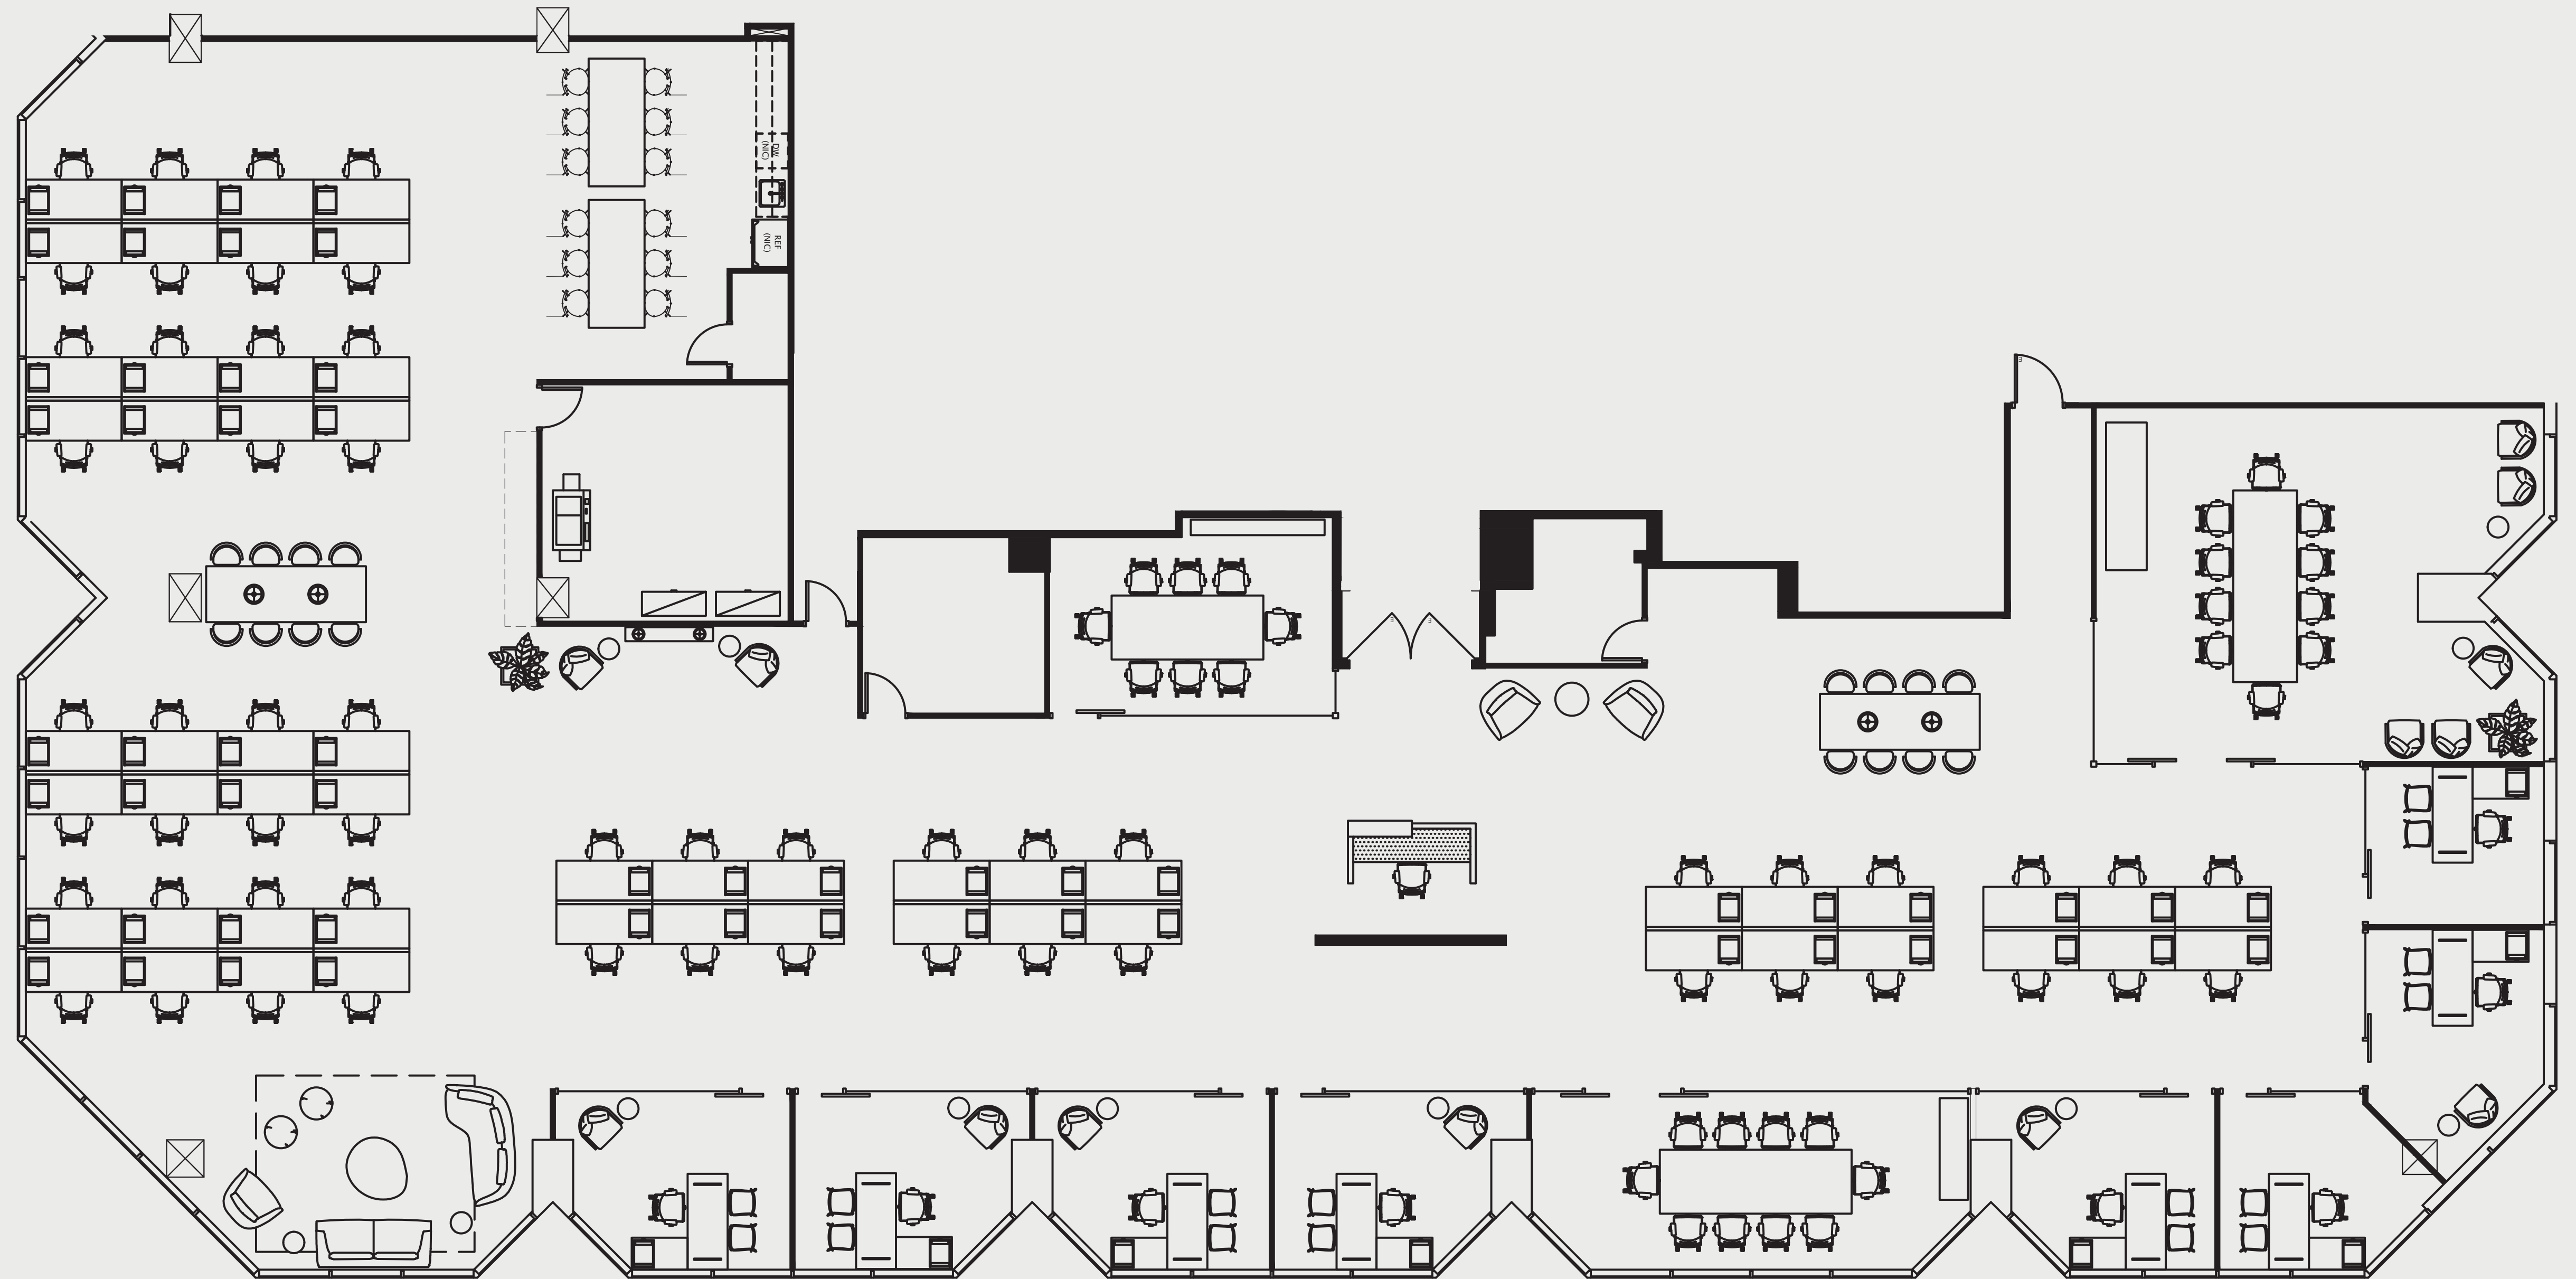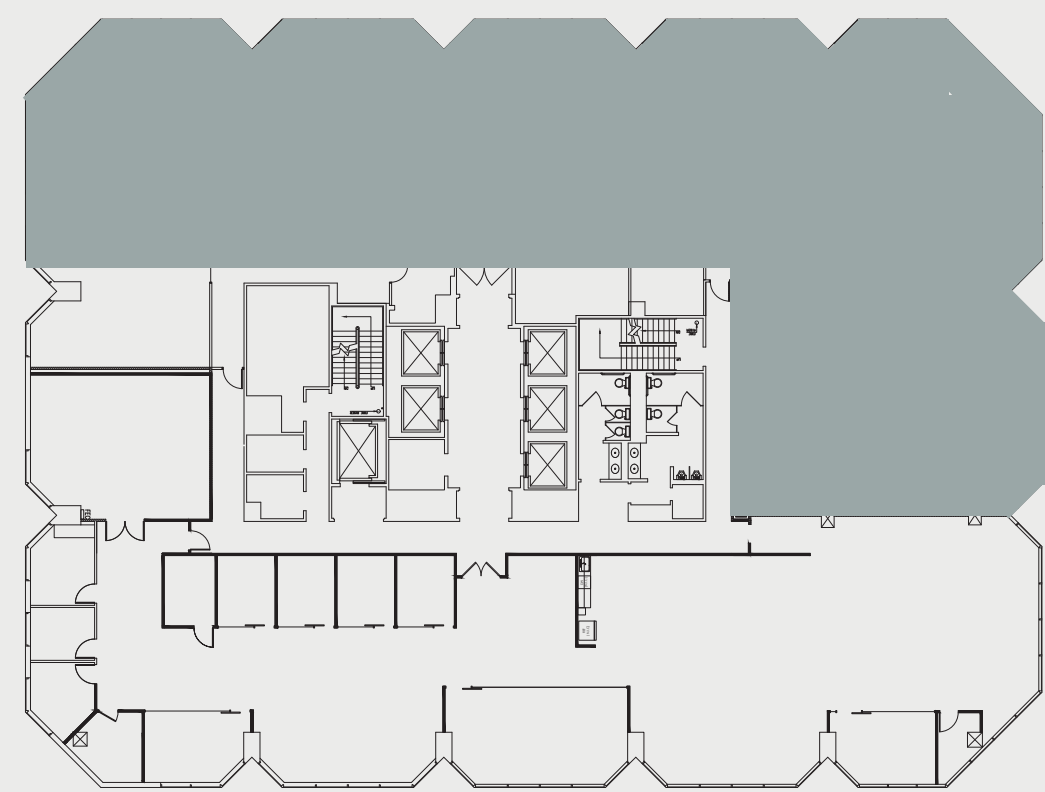

For leasing information please contact:
USALEASING@ONNI.COM
(213) 629-2041

