

SUITE: 201



RSF: 2,830

AS-BUILT CONFIGURATION

- OFFICES..... 4
- RECEPTION..... 1
- CONFERENCE ROOMS..... 1
- KITCHEN..... 1
- OPEN WORK AREA..... +/- 18

KEY PLAN:

Not to scale, furniture and appliances not included

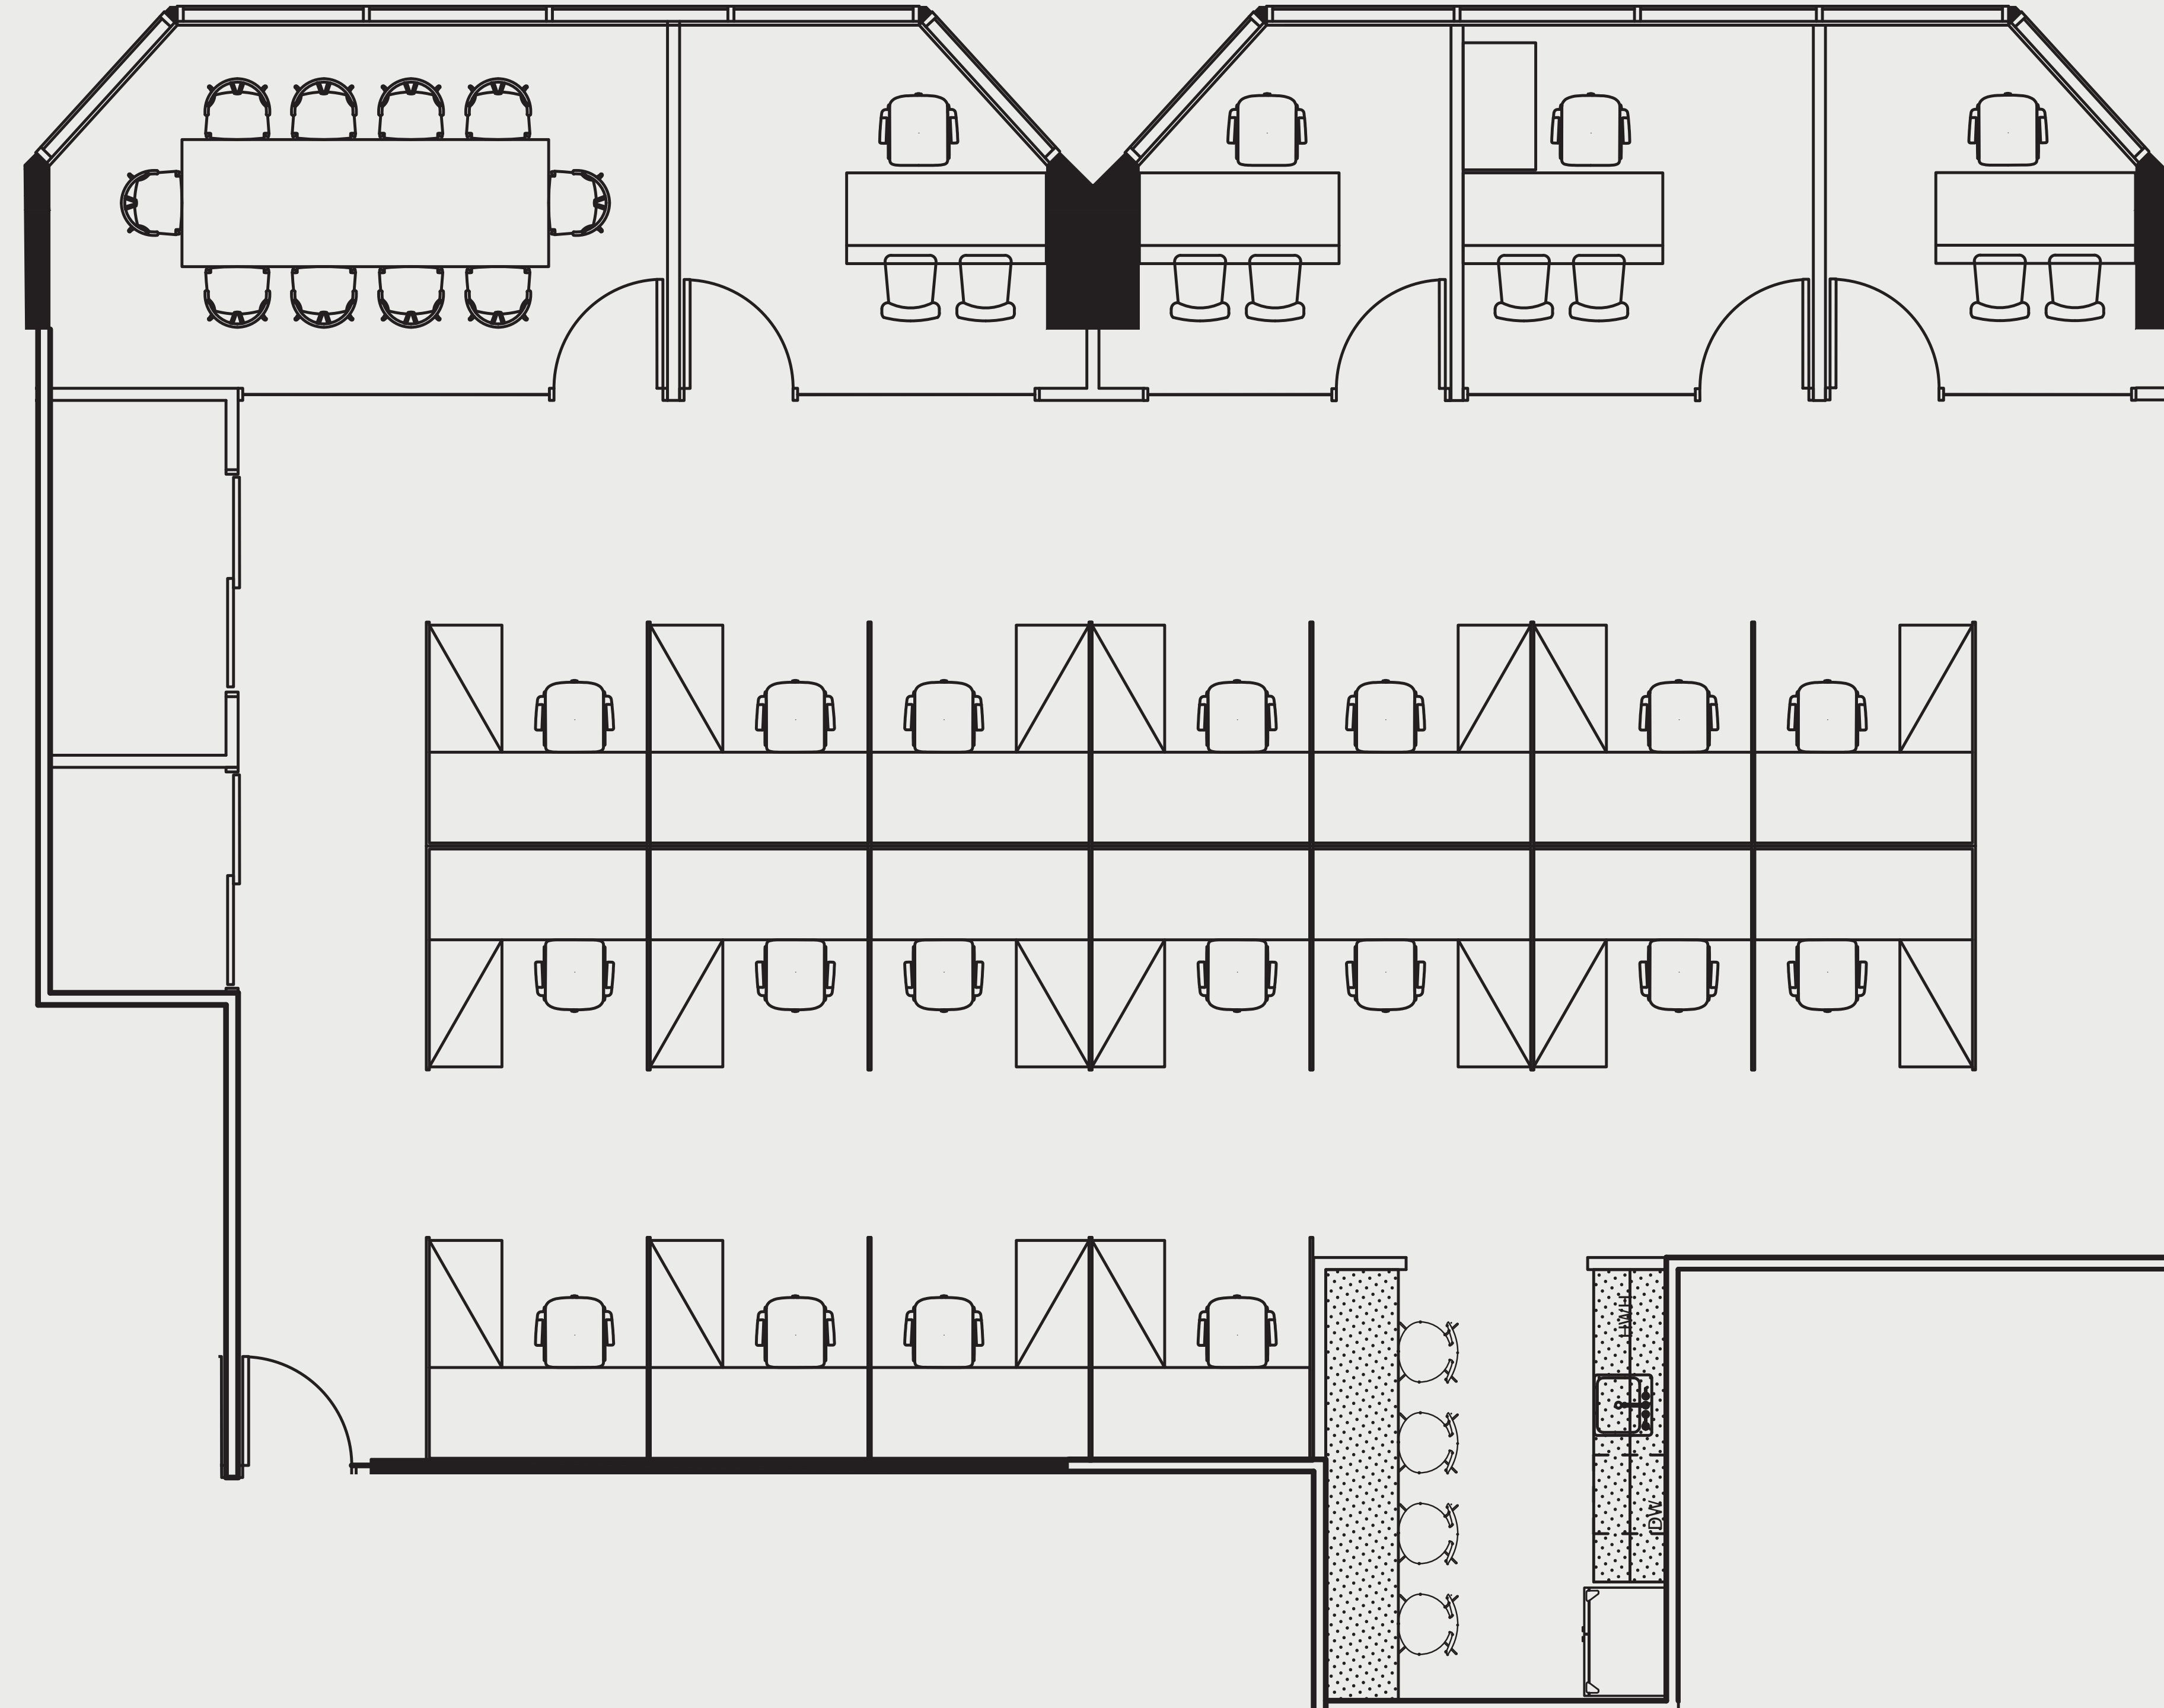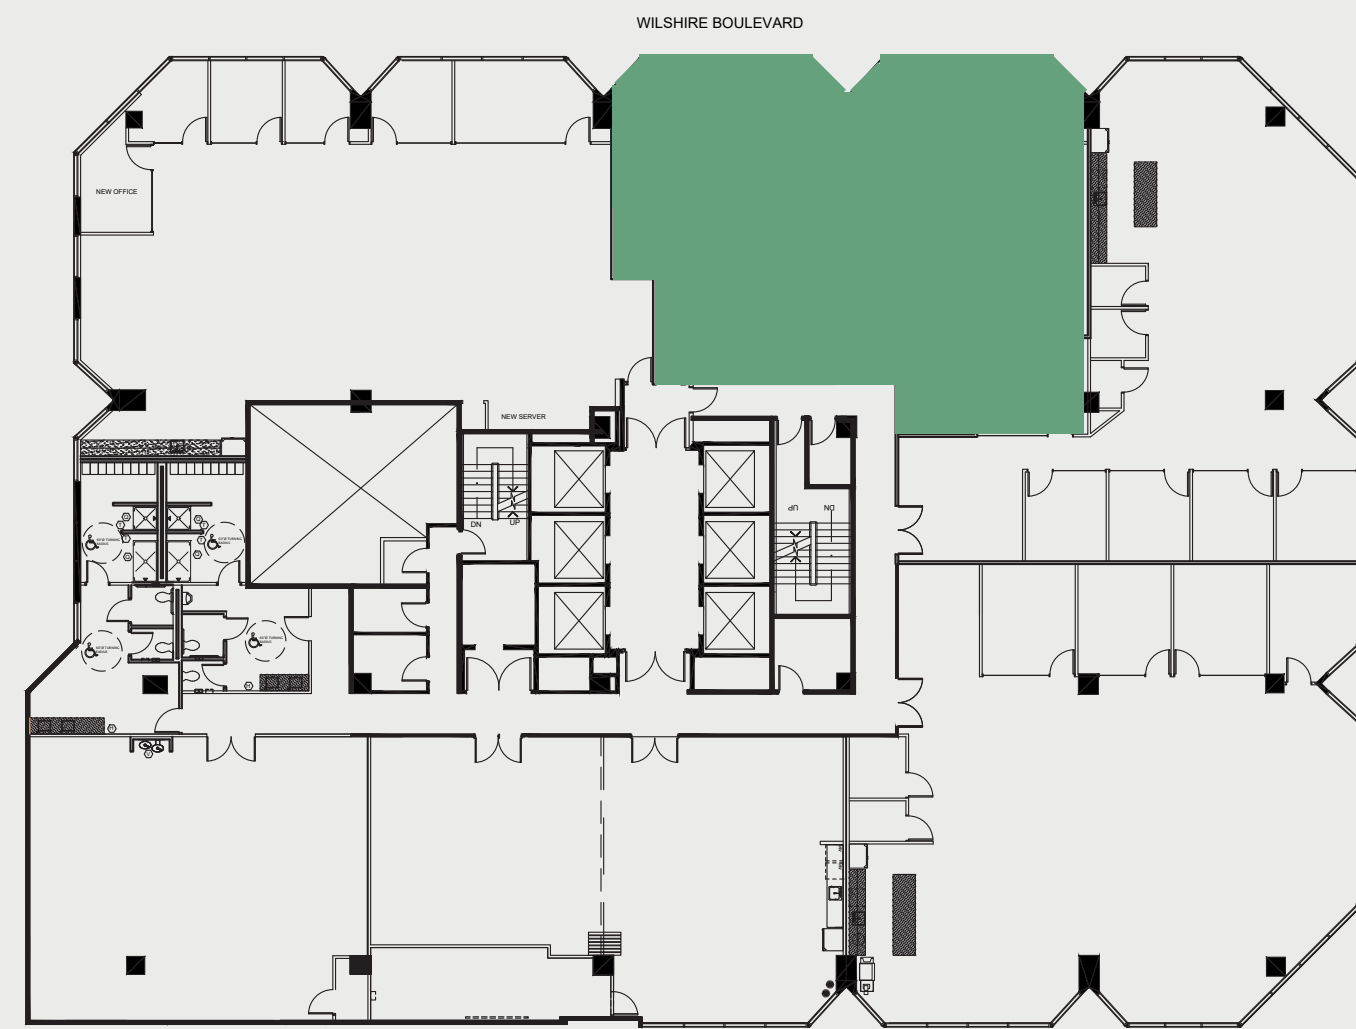

For leasing information please contact:

Nico Vilgiate
213.532.3236 | nico.vilgiate@colliers.com

Nick Moscicki
213.861.3345 | nick.moscicki@colliers.com