


AS-BUILT CONFIGURATION

- OFFICES..... 3
- RECEPTION..... 1
- CONFERENCE ROOMS..... 1
- KITCHEN..... 1
- OPEN WORK AREA..... +/- 26

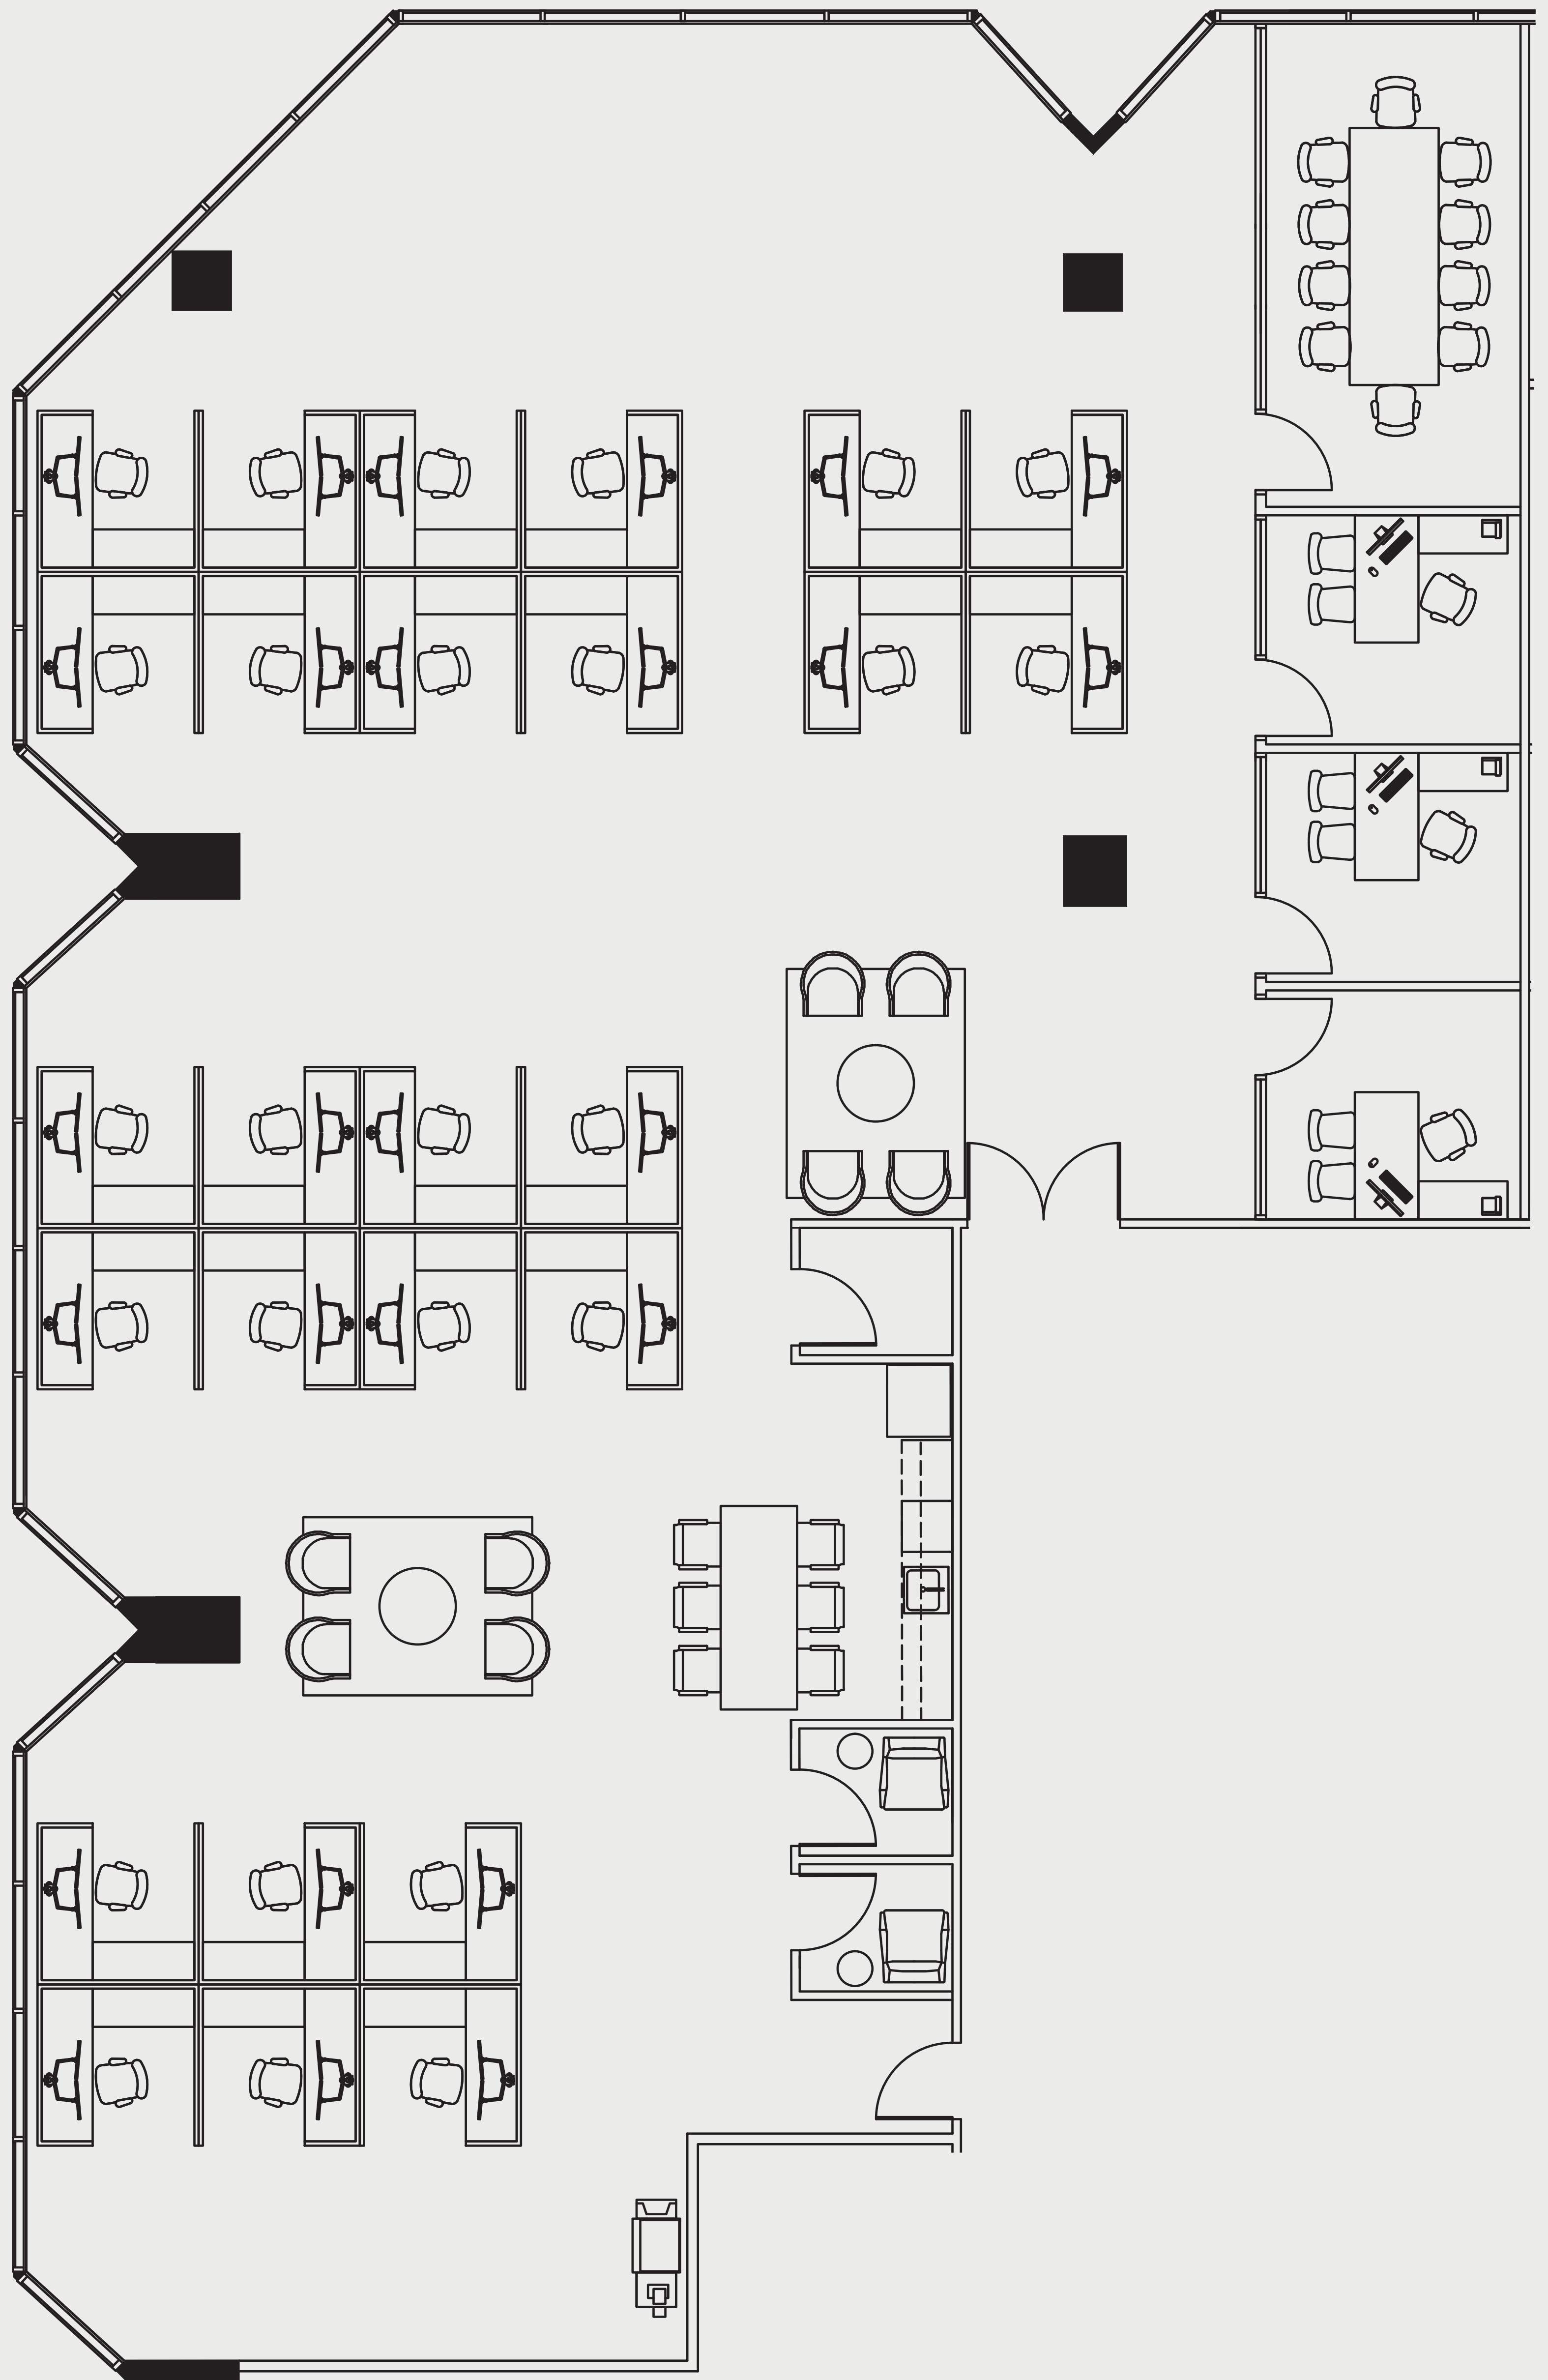

KEY PLAN:

Not to scale, furniture and appliances not included

