

# SUITE: 302

# RSF: 4,246





## AS-BUILT CONFIGURATION

- PRIVATE OFFICES.....6
- CONFERENCE ROOMS.....1
- KITCHEN.....1
- OPEN WORK AREA.....+/-12

## KEY PLAN:

*Not to scale, furniture and appliances not included*

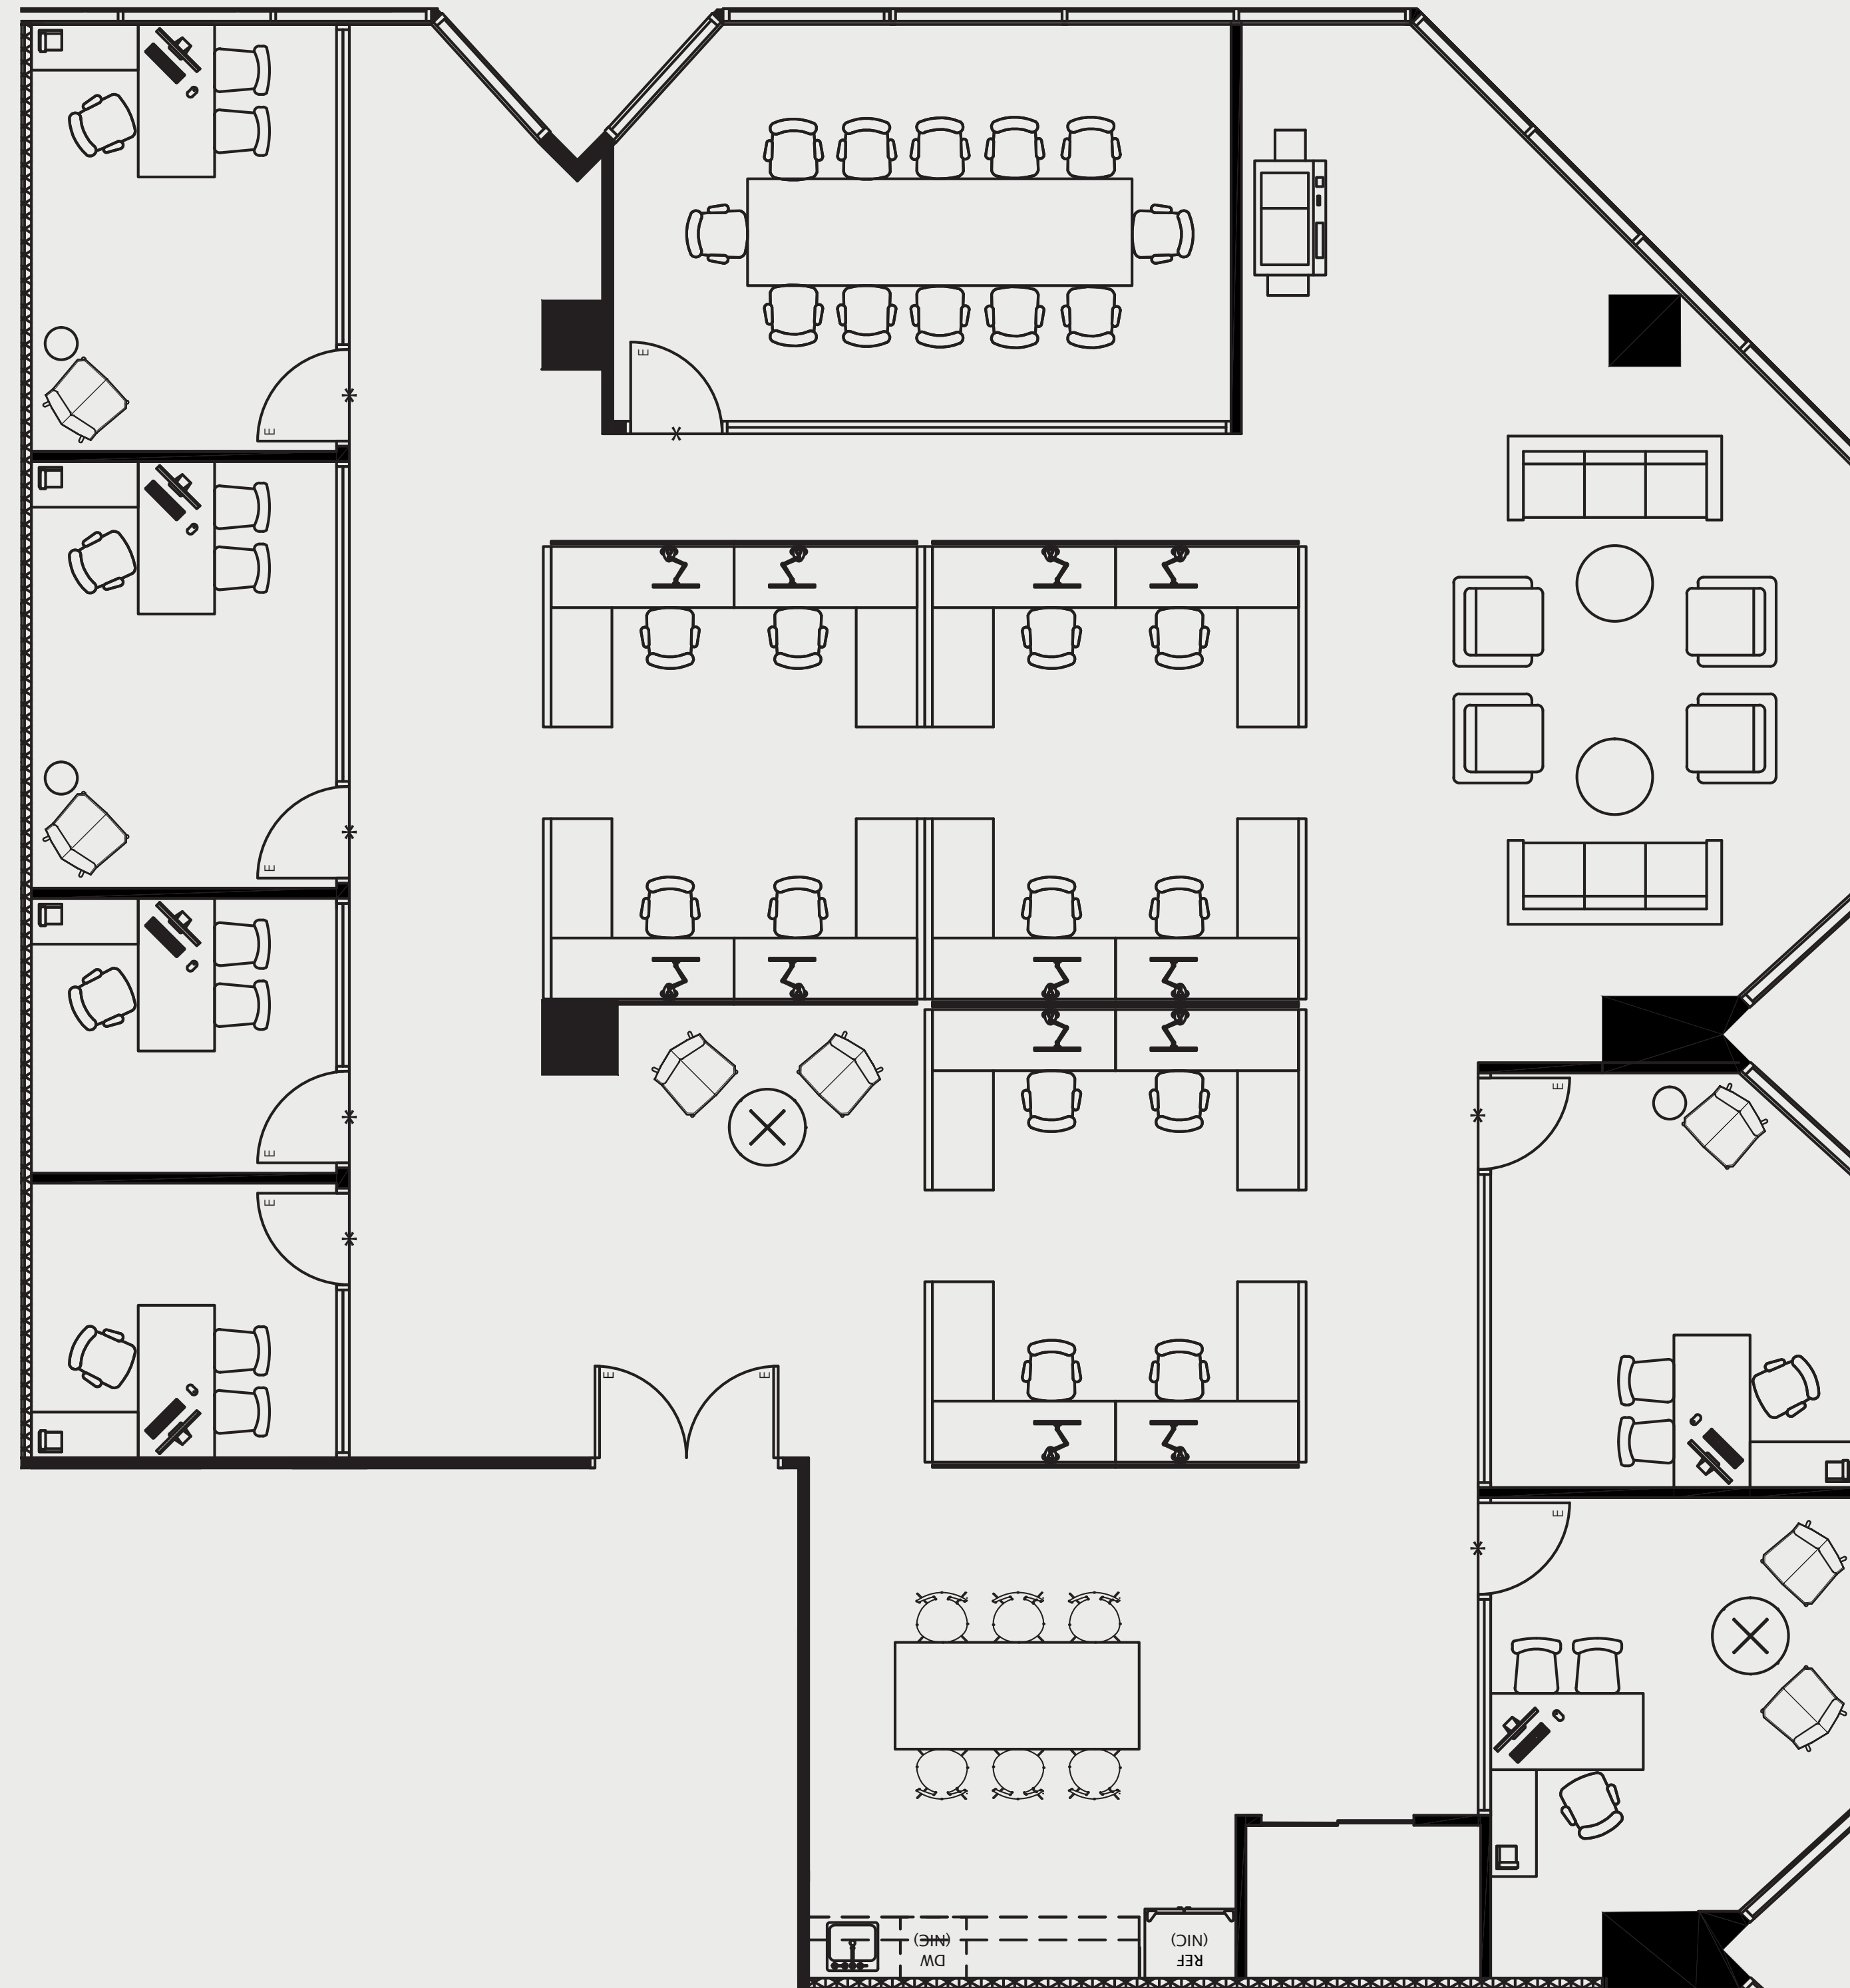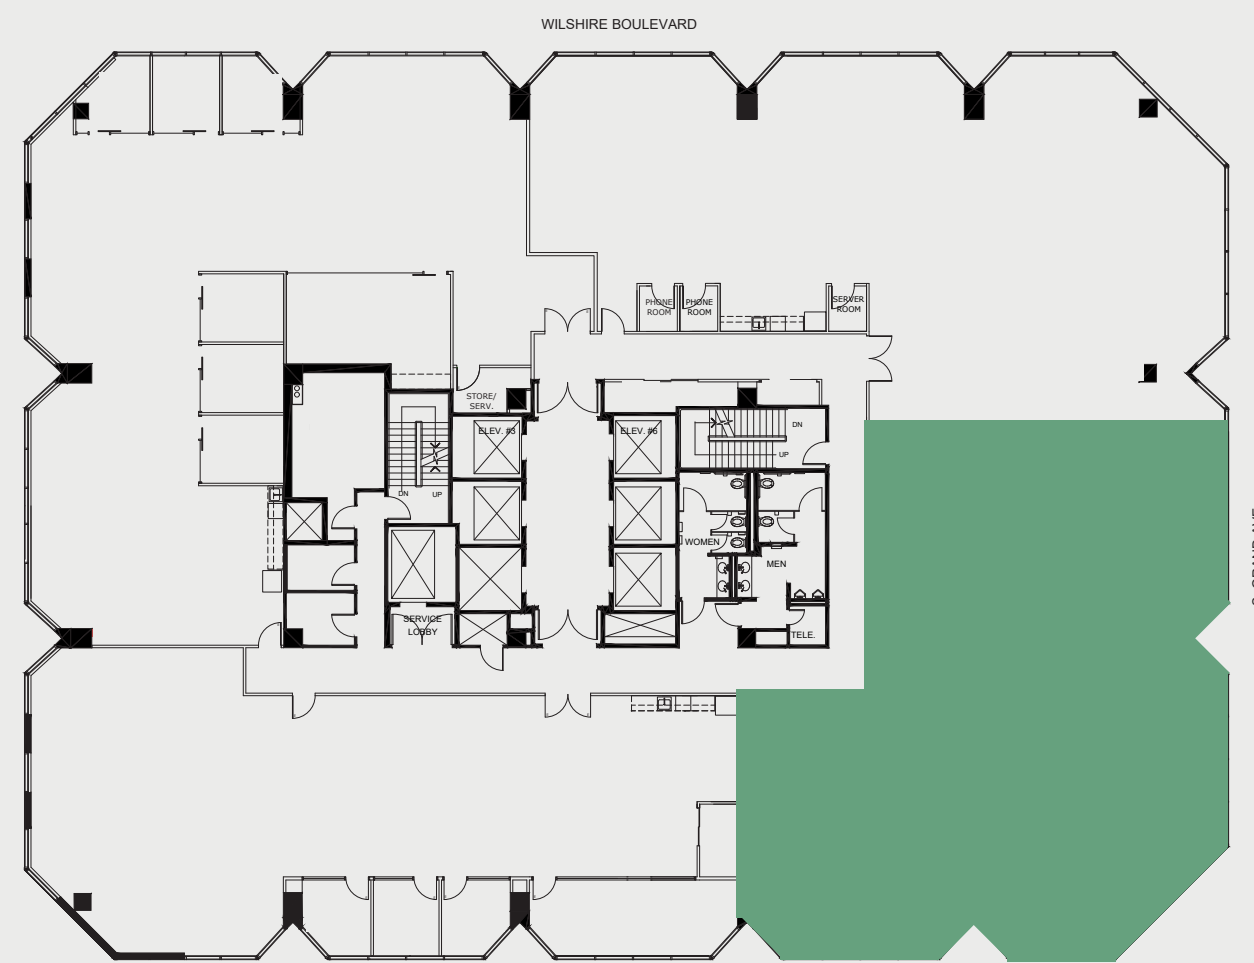

For leasing information please contact:  
USALEASING@ONNI.COM  
(213) 629-2041

