

SUITE: 303

RSF: 2,607




AS-BUILT CONFIGURATION

- RECEPTION.....1
- PANTRY.....1
- CONFERENCE ROOMS.....1
- PRIVATE OFFICES.....3
- OPEN WORK AREA.....+/-9

KEY PLAN:

Not to scale, furniture and appliances not included

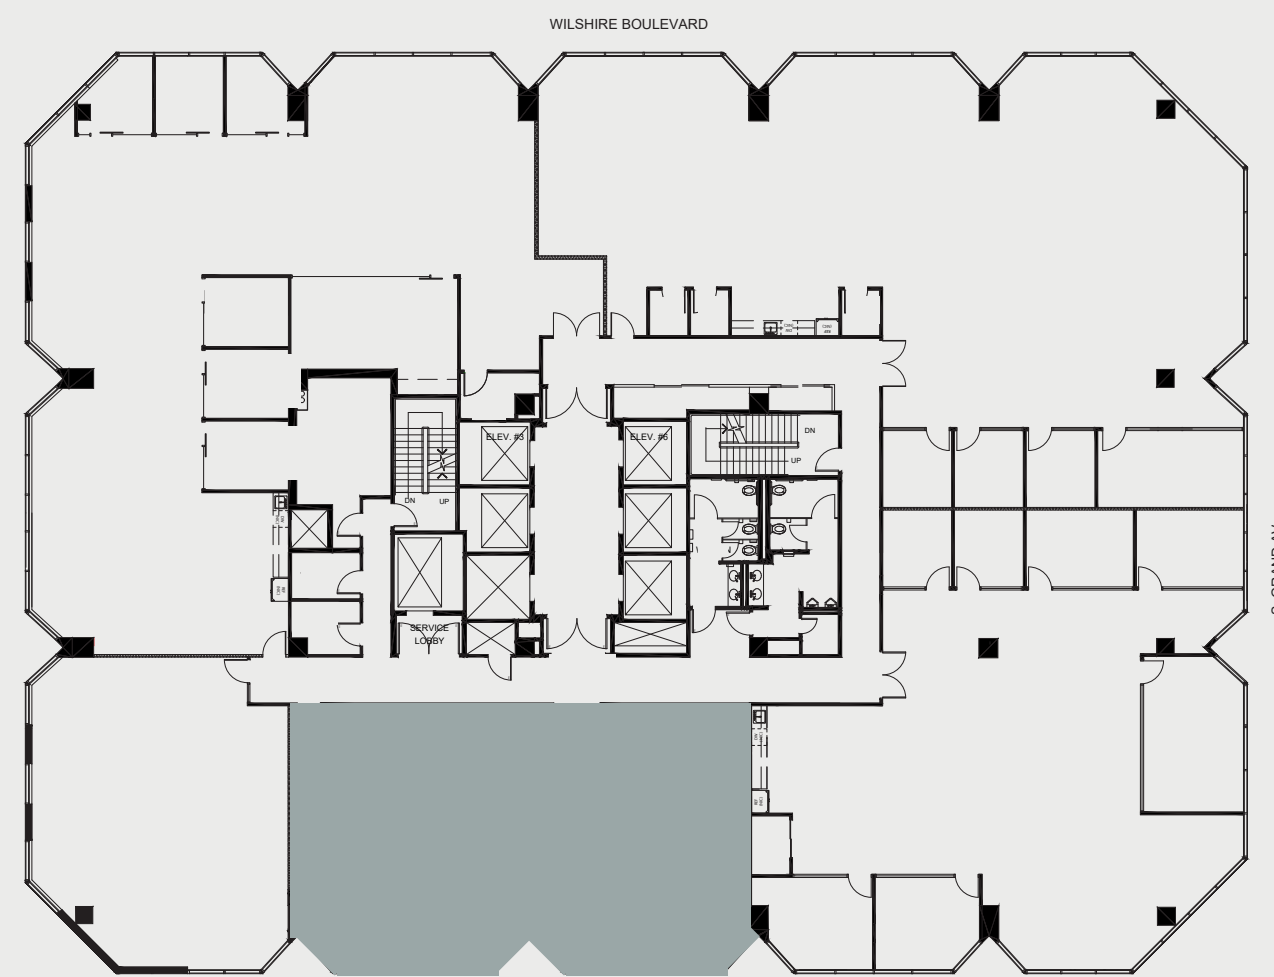

For leasing information please contact:
USALEASING@ONNI.COM
(213) 629-2041

