


RSF: 5,140

AS-BUILT CONFIGURATION

OFFICES	6
RECEPTION	1
CONFERENCE ROOMS	.1
KITCHEN	1
OPEN WORK AREA	+/- 40

KEY PLAN: *Not to scale, furniture and appliances not included*

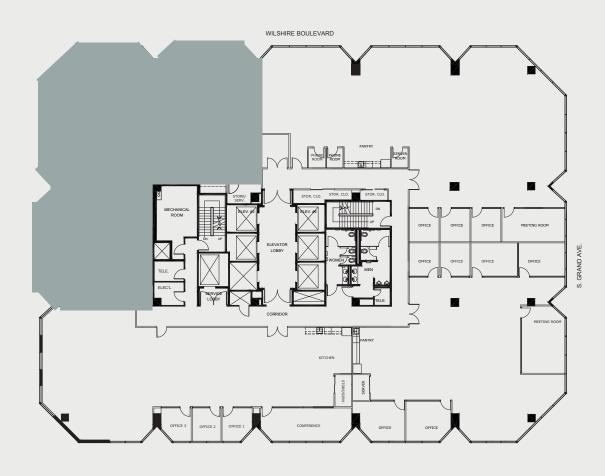

For leasing information please contact: USALEASING@ONNI.COM (213) 629-2041

