

SUITE: 400

RSF: 18,862





AS-BUILT CONFIGURATION

- PRIVATE OFFICES.....5
- RECEPTION.....1
- CONFERENCE ROOMS.....9
- KITCHEN.....1
- PHONE ROOMS.....5
- OPEN WORK AREA.....+/- 134

KEY PLAN:

*Not to scale, furniture and appliances not included*

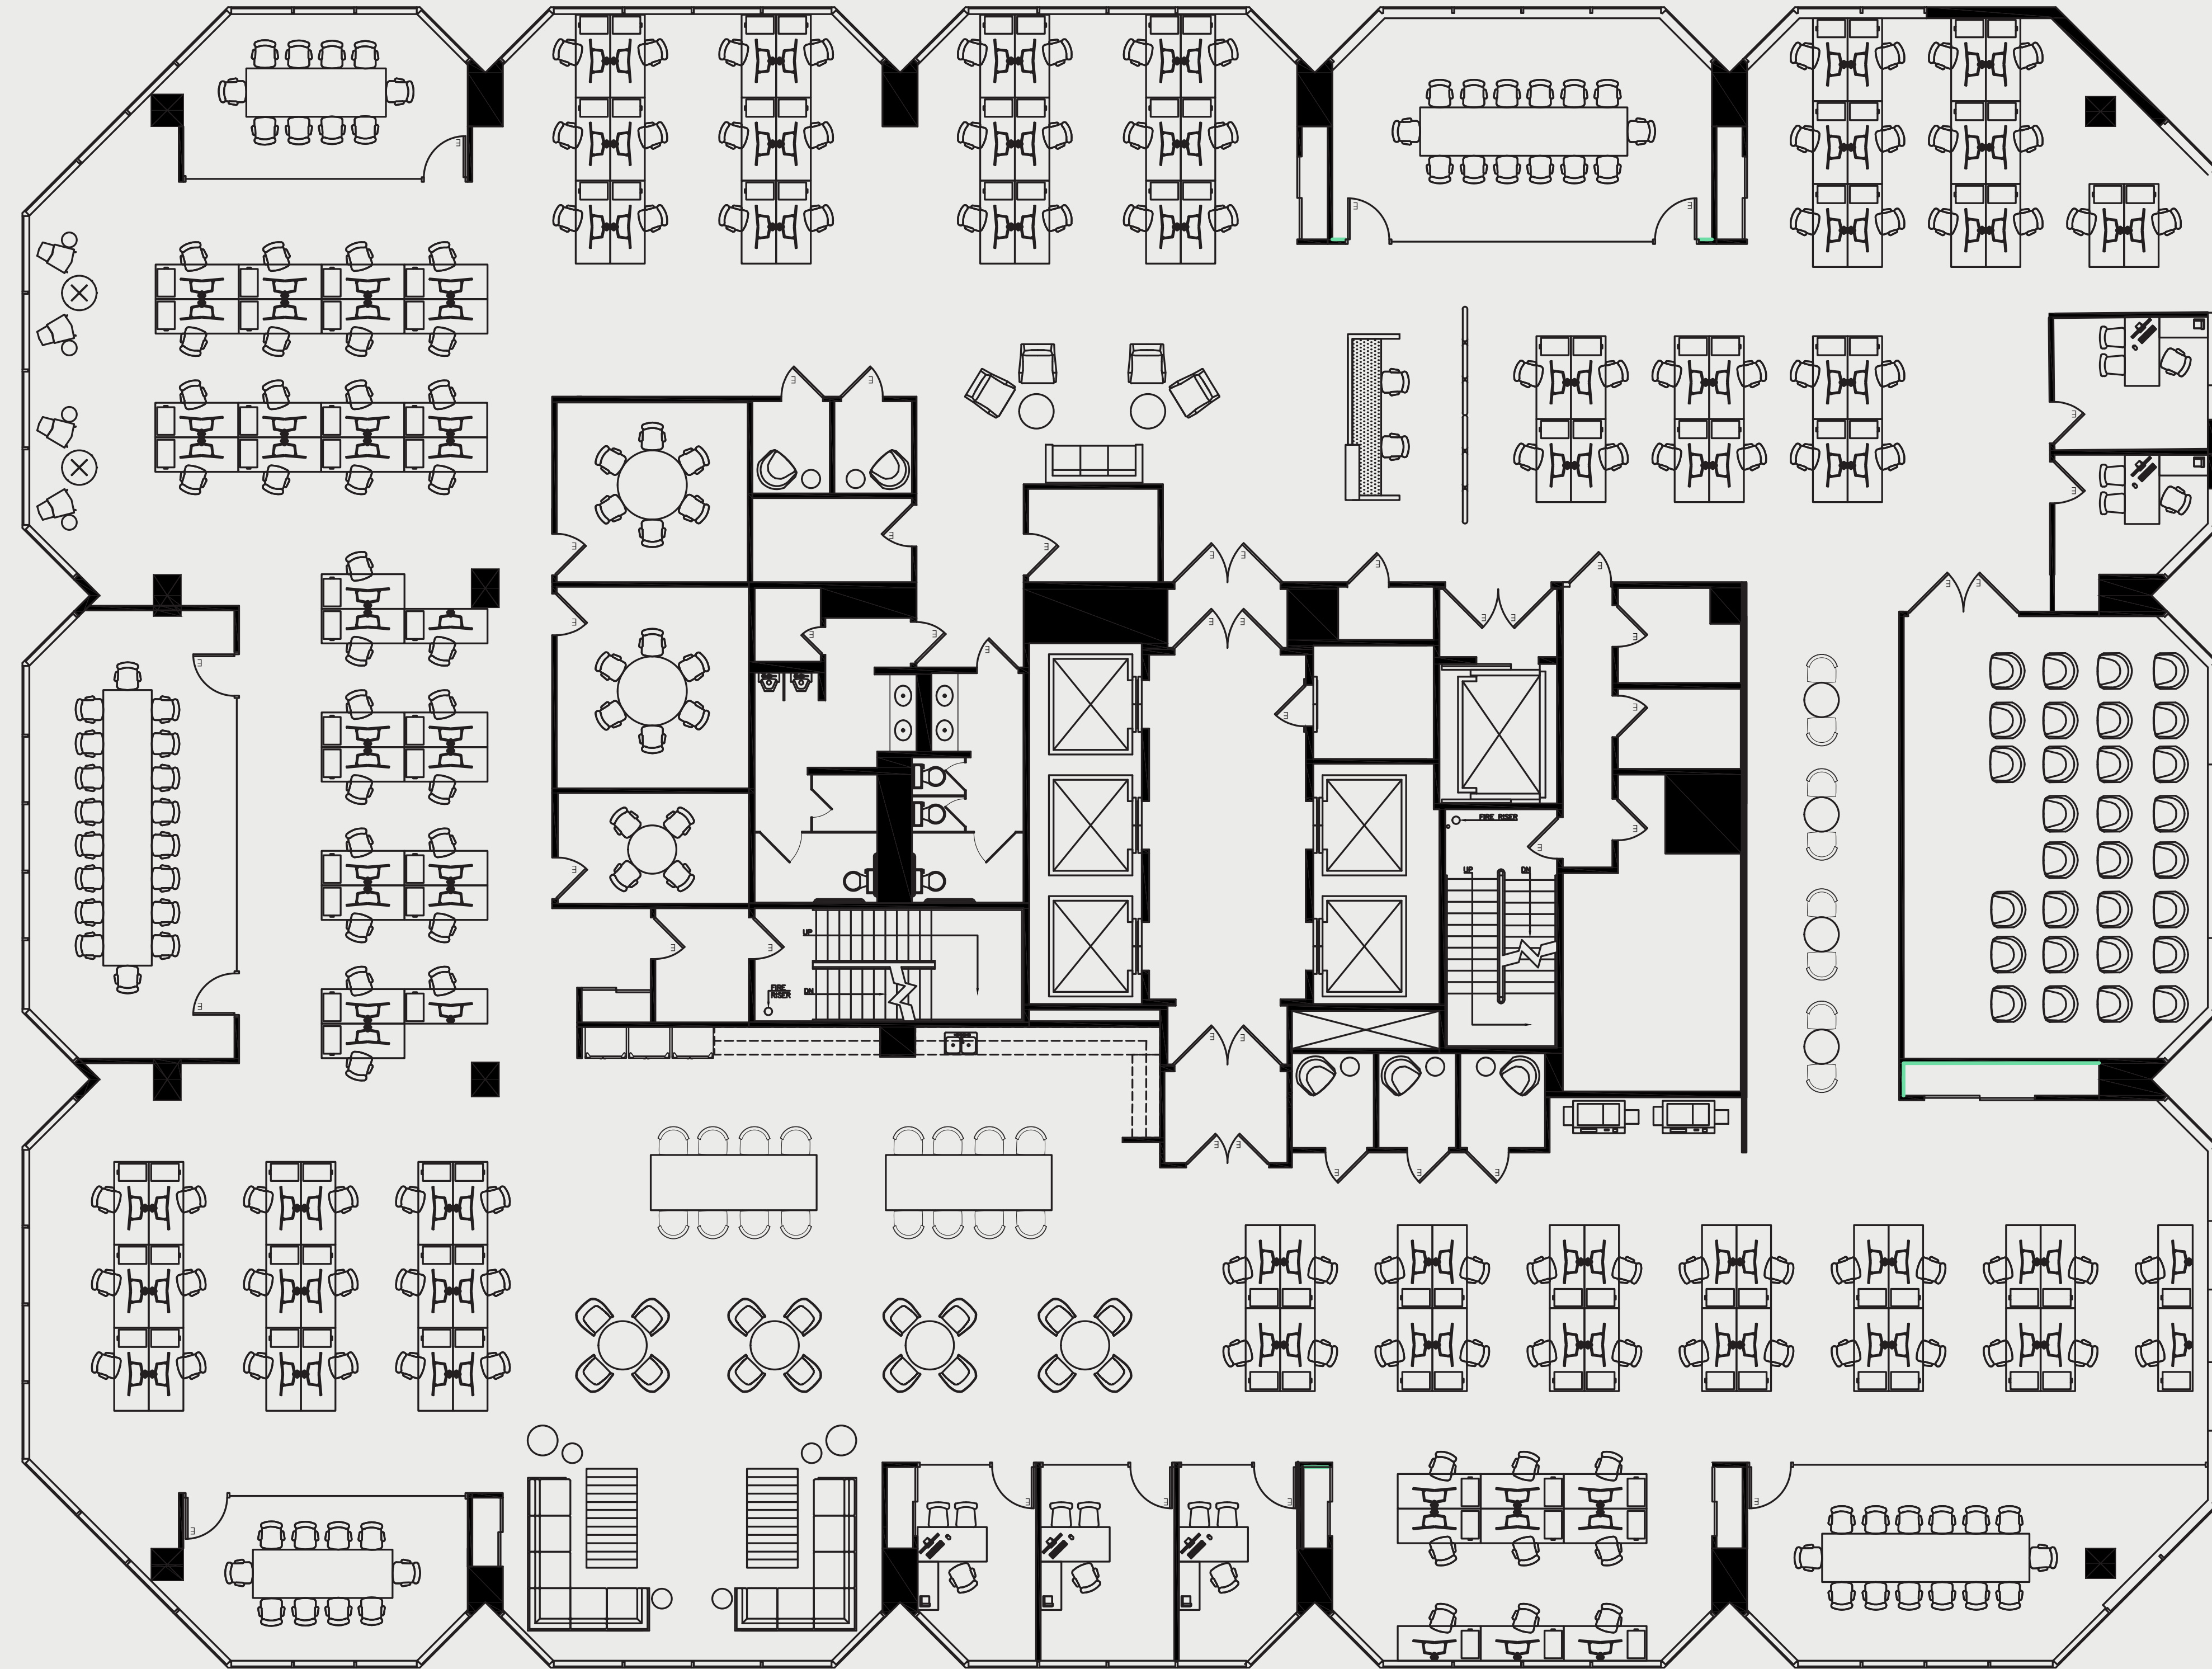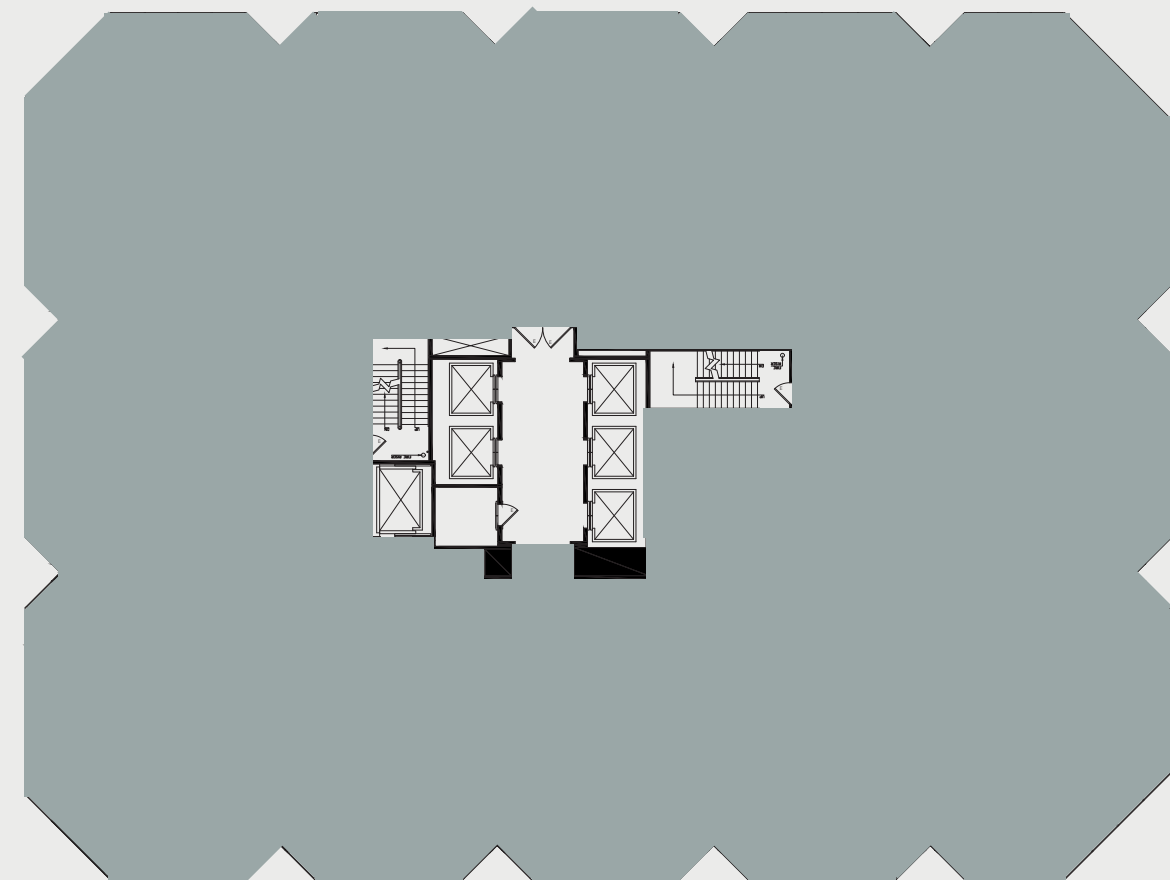

PLEASE CONTACT:  
USALEASING@ONNI.COM  
(213) 629 - 2041