

SUITE: 500


RSF: 18,862



AS-BUILT CONFIGURATION

OFFICES.....	88
RECEPTION.....	2
CONFERENCE ROOMS.....	2
KITCHEN.....	1
OPEN WORK AREA.....	N/A

KEY PLAN:
Not to scale, furniture and appliances not included

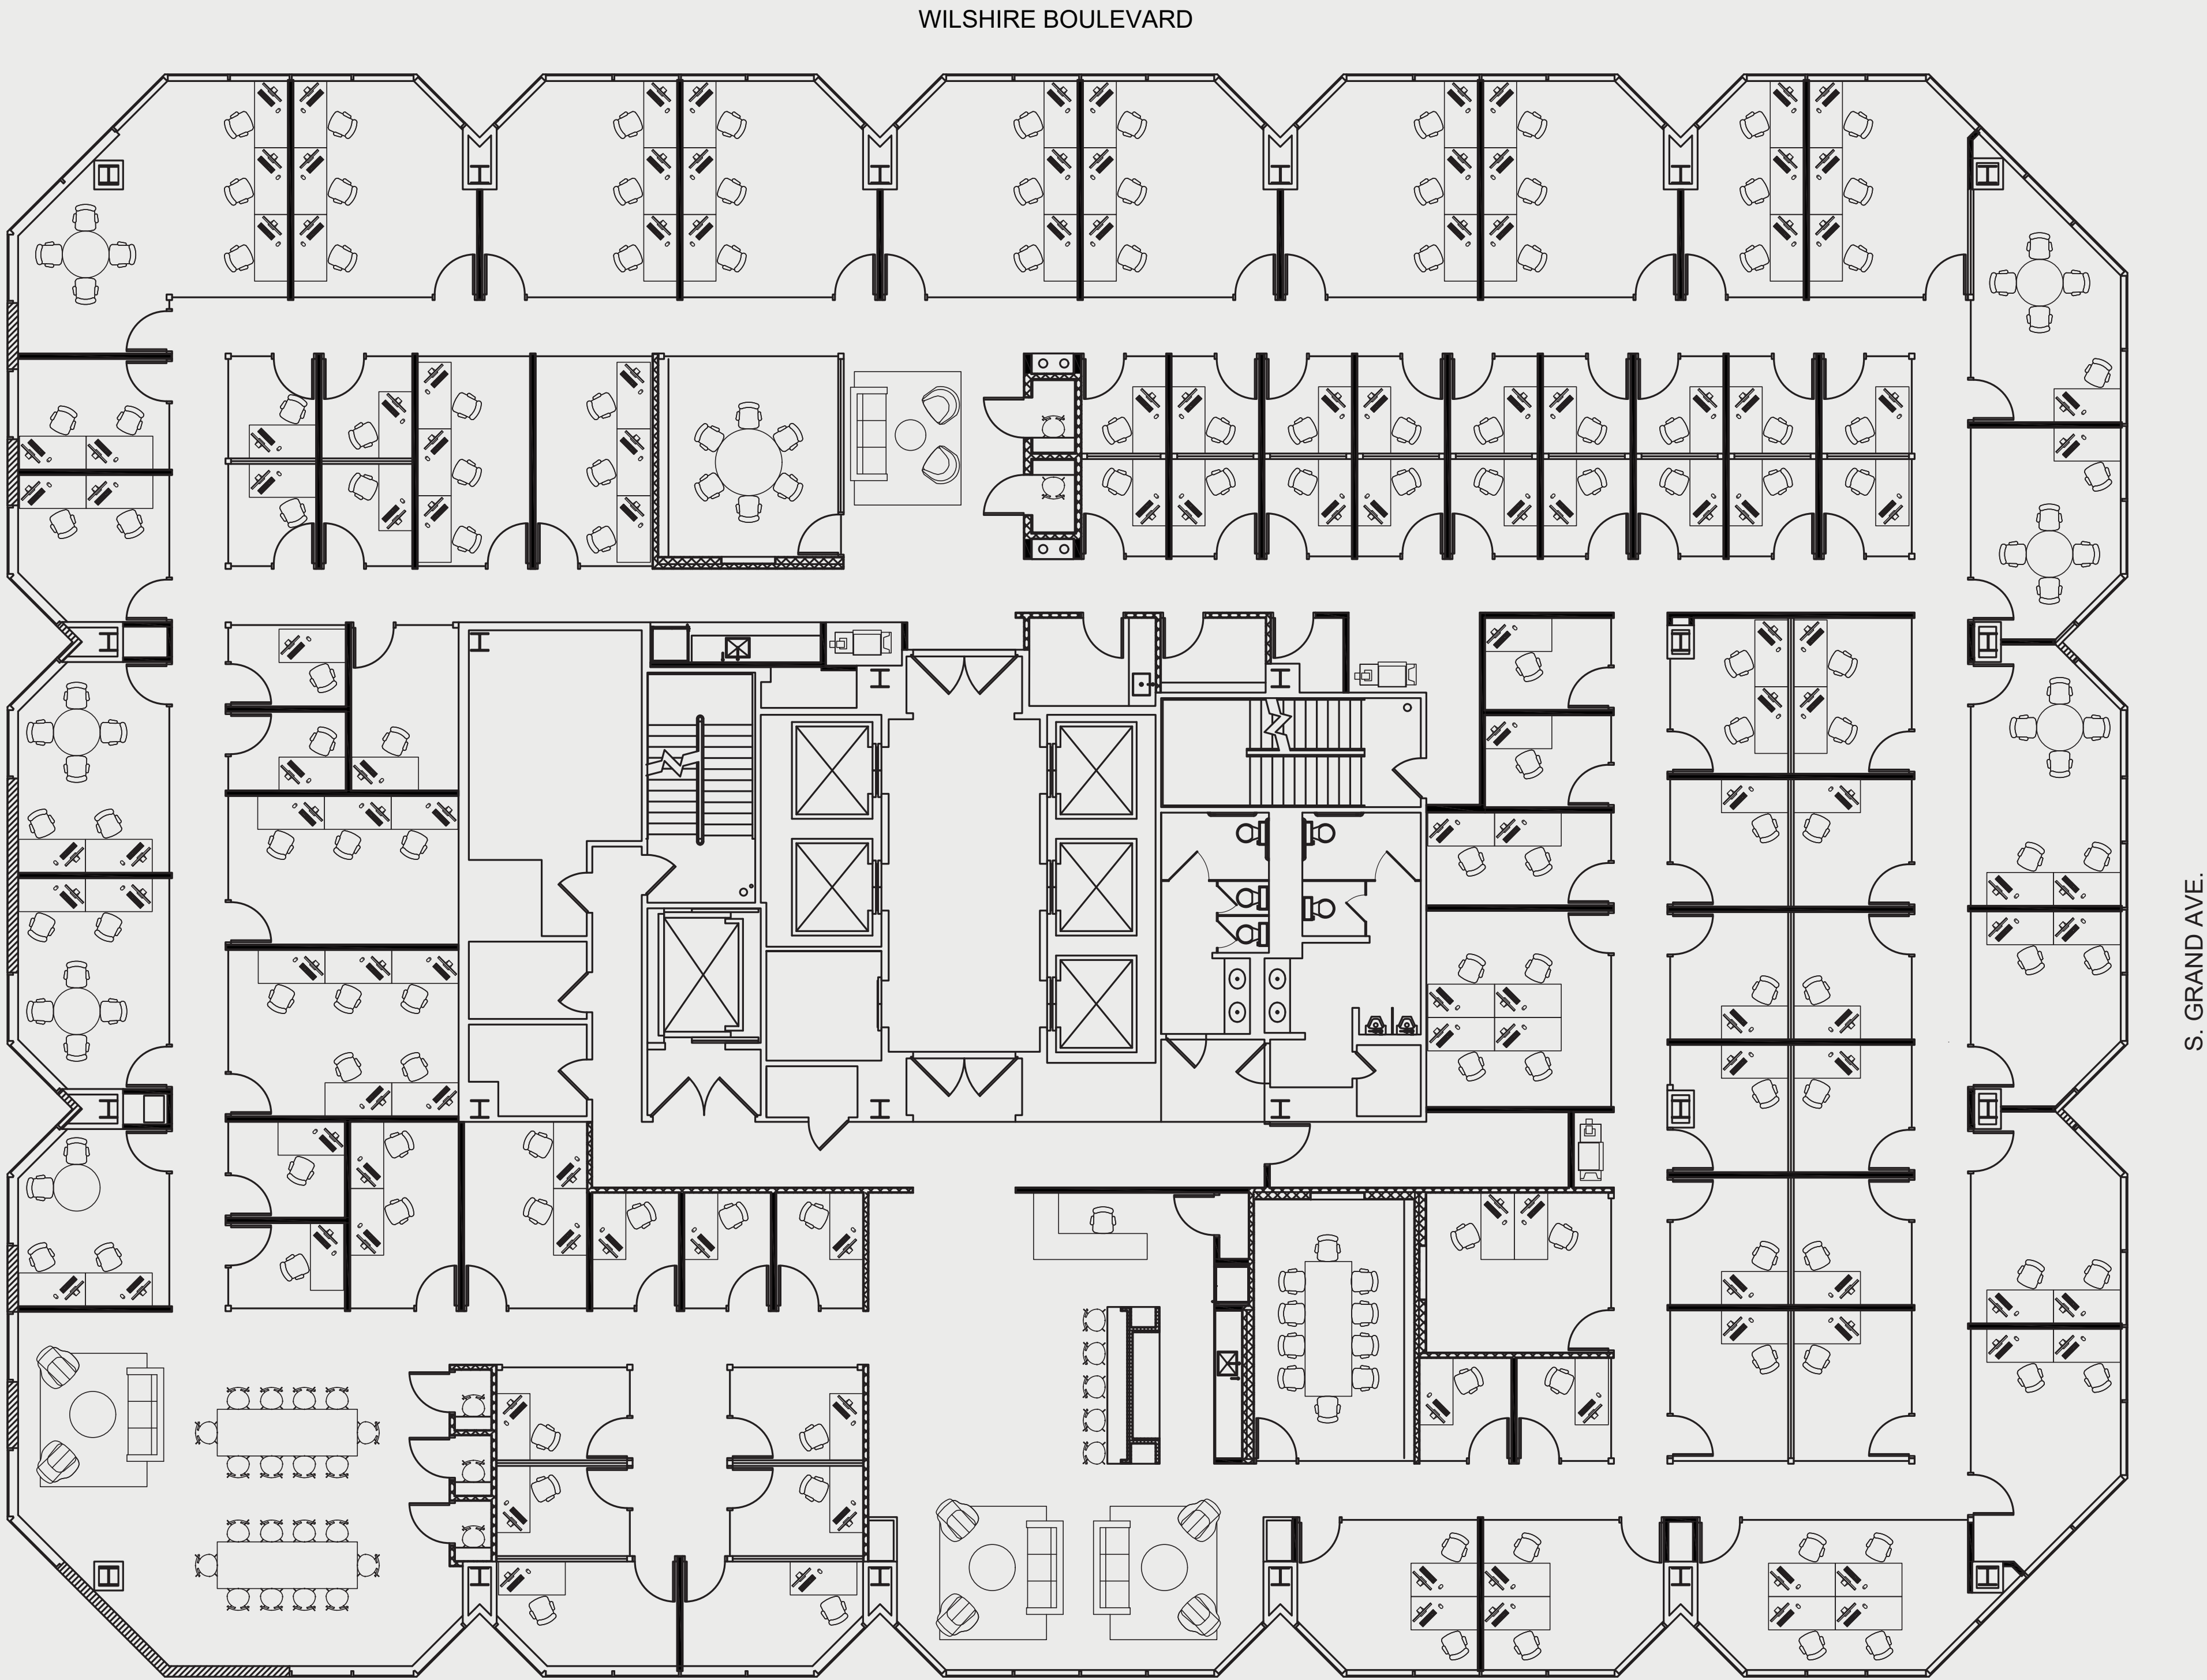

For leasing information please contact:
USALEASING@ONNI.COM
(213) 629-2041

