



SUITE: 600      RSF: 6,589



AS-BUILT CONFIGURATION

- OFFICES..... 22
- RECEPTION..... 1
- CONFERENCE ROOMS..... 1
- KITCHEN..... 1
- OPEN WORK AREA..... +/- 1

KEY PLAN:  
*Not to scale, furniture and appliances not included*

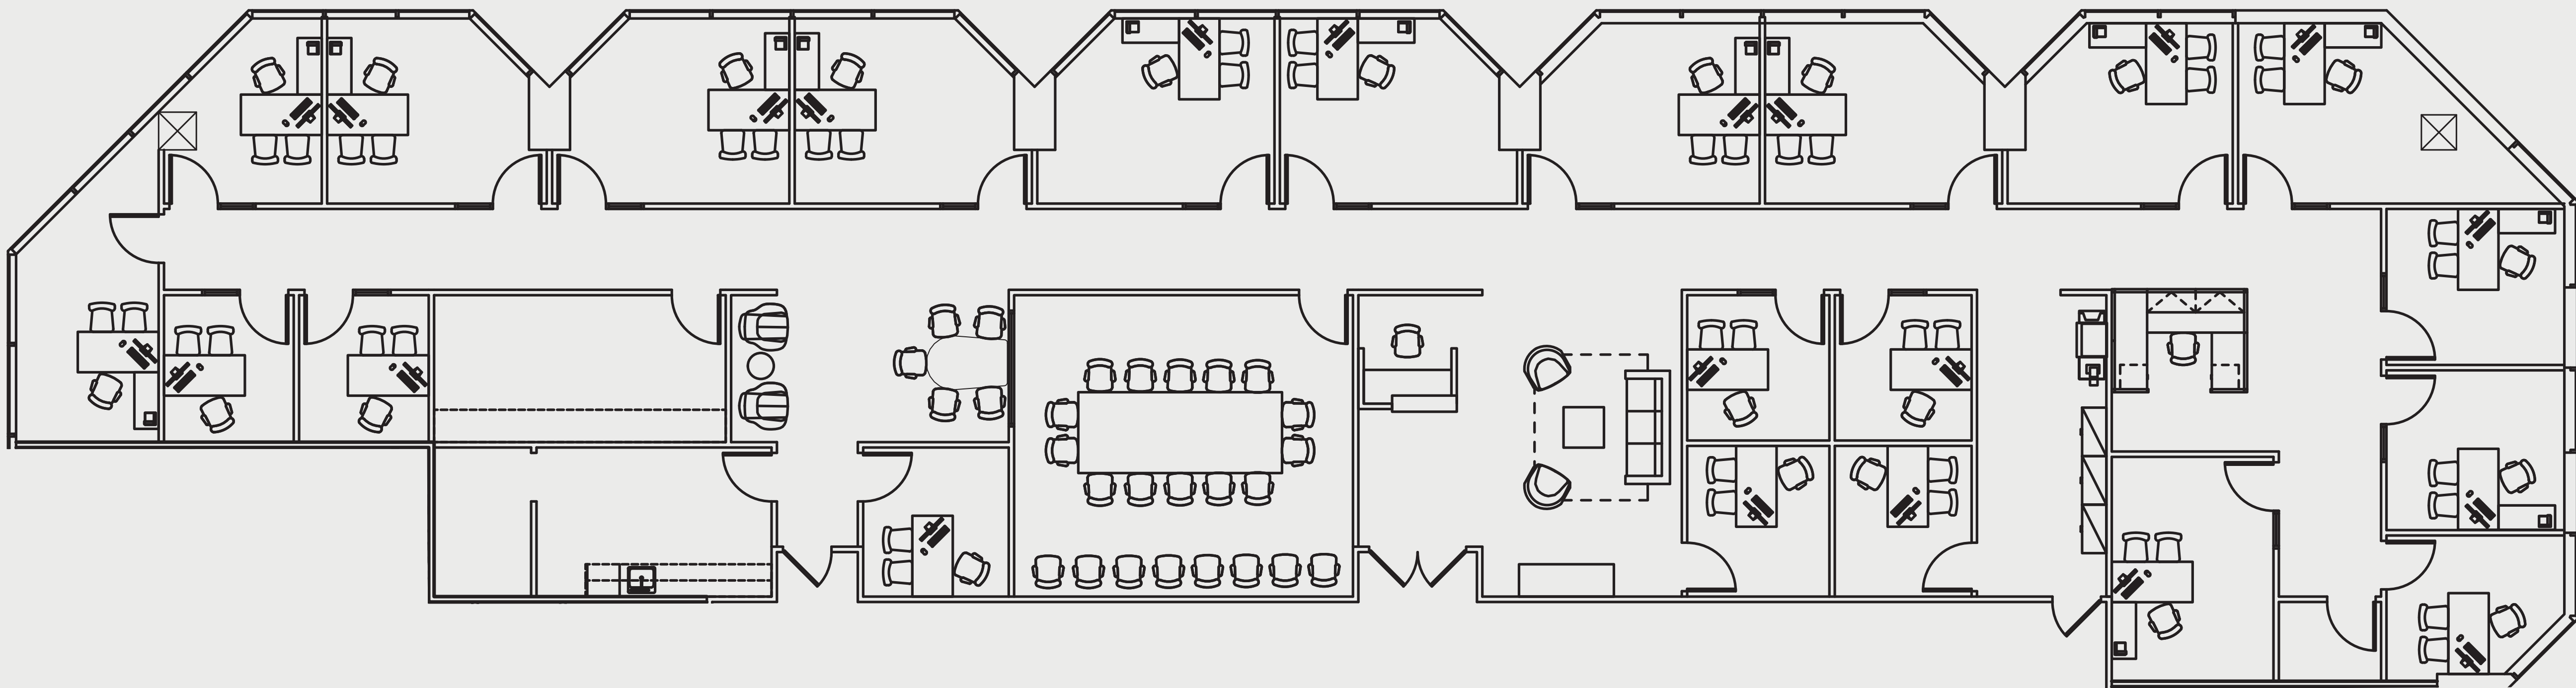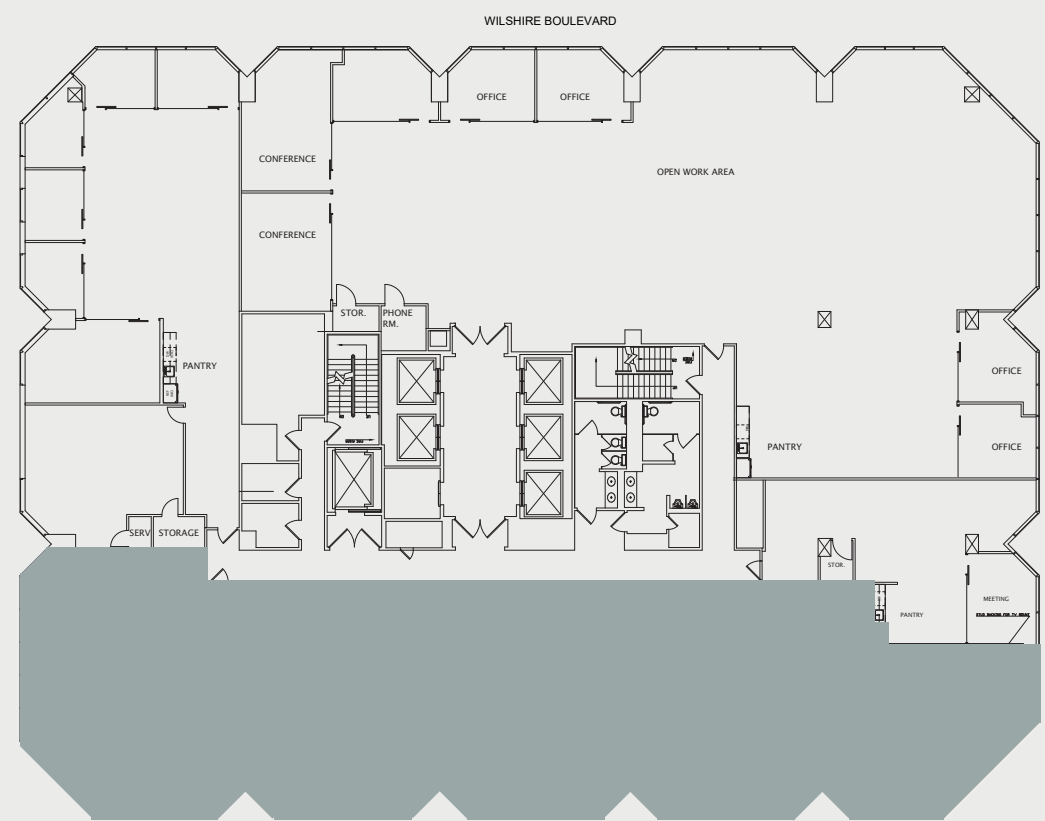

For leasing information please contact:  
USALEASING@ONNI.COM  
(213) 629-2041

