SUITE: 1550 RSF: 5,775

600 WILSHIRE

AS-BUILT CONFIGURATION

OFFICES..... N/A

RECEPTION..... N/A

CONFERENCE ROOMS.....N/A

KITCHEN..... N/A

OPEN WORK AREA..... N/A

KEY PLAN:

Not to scale, furniture and appliances not included

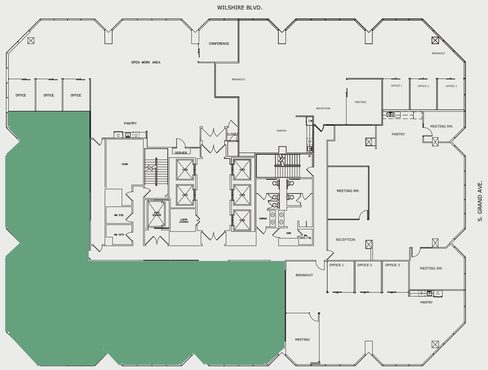

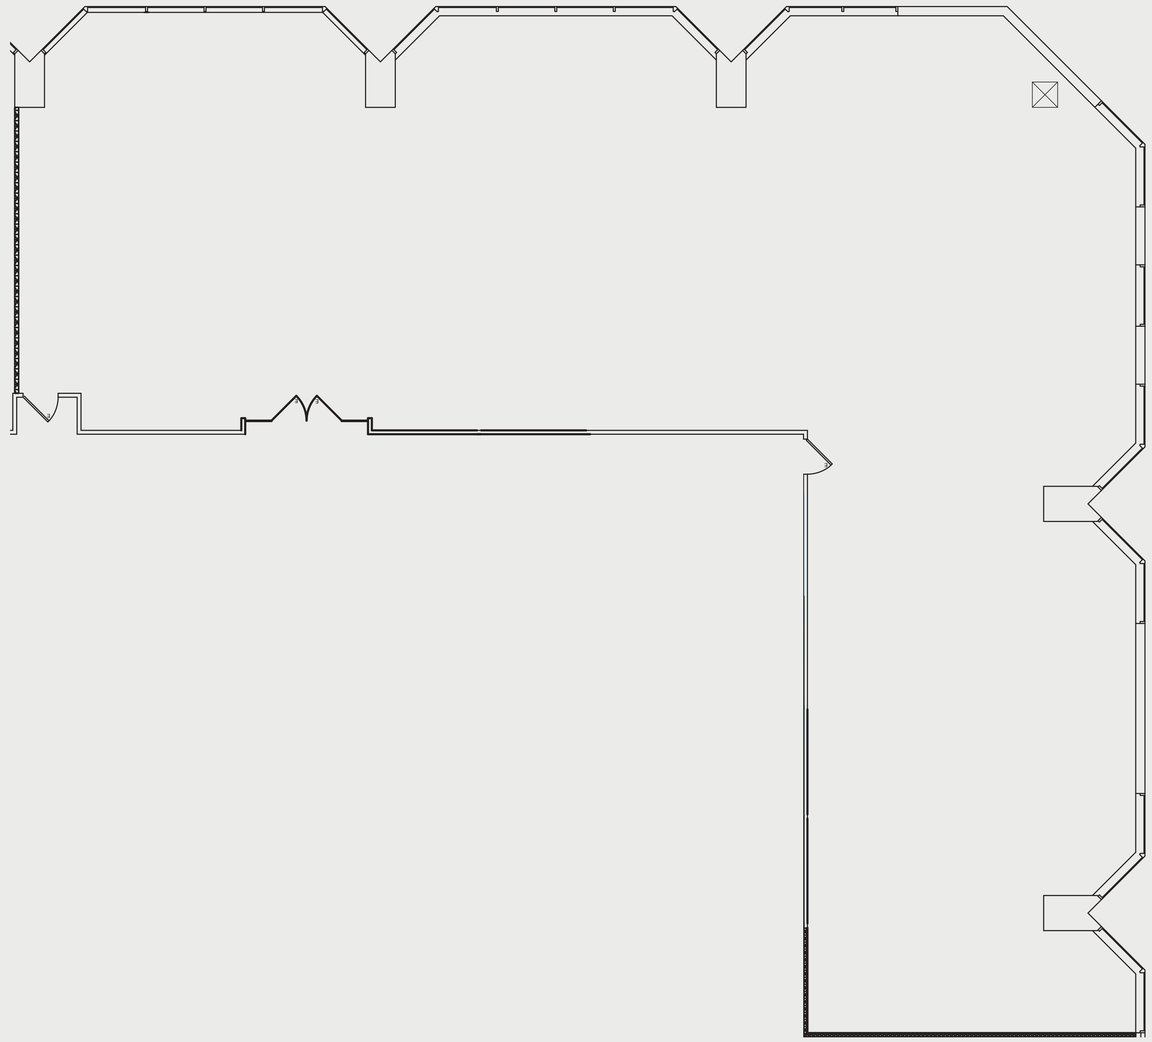

For leasing information please contact:

Nico Vilgiate
213.532.3236 | nico.vilgiate@colliers.com

Nick Moscicki
213.861.3345 | nick.moscicki@colliers.com

onni group