# SUITE: 1150 RSF: 2,937

600 WILSHIRE

## AS-BUILT CONFIGURATION

OFFICES.....6

RECEPTION.....1

CONFERENCE ROOM.....1

KITCHEN.....1

OPEN WORK AREA.....+/-14

## KEY PLAN:

*Not to scale, furniture and appliances not included*

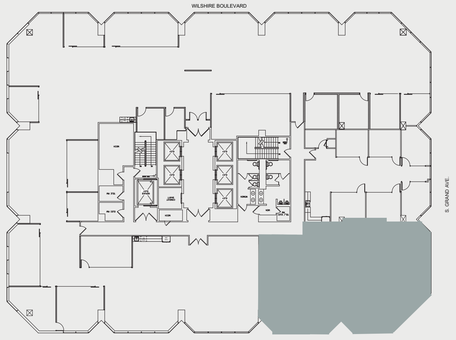


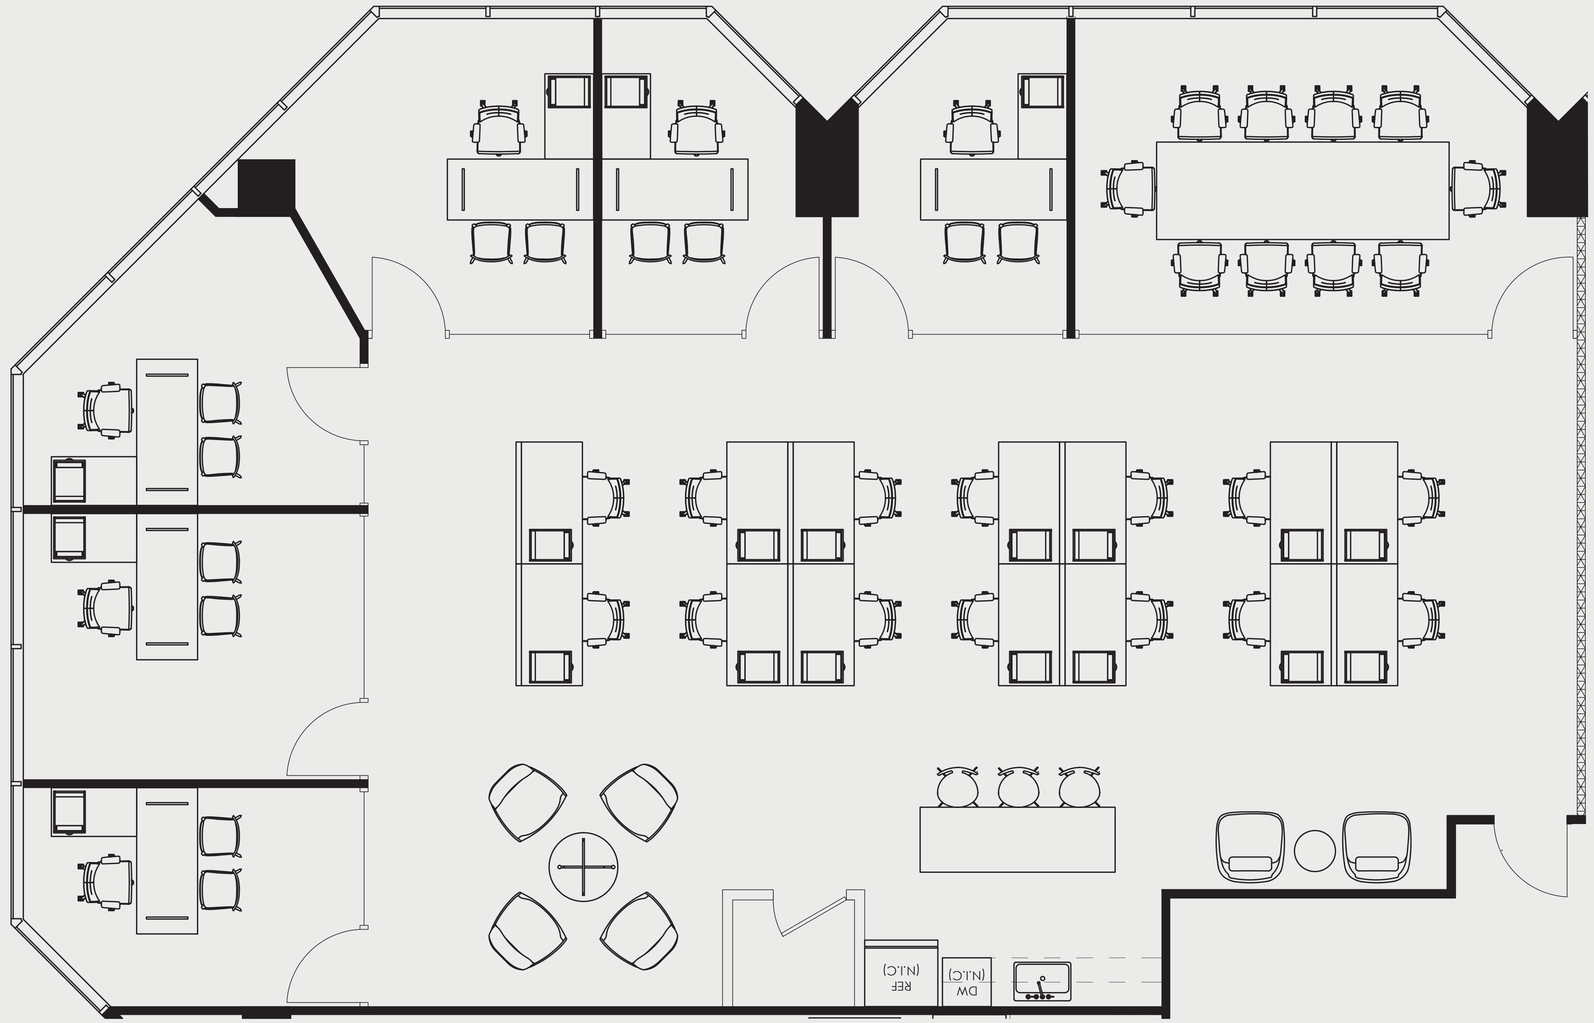


onni group