SUITE: 1400 RSF: 4,884

600 WILSHIRE

AS-BUILT CONFIGURATION

PRIVATE OFFICES.....8

RECEPTION.....1

CONFERENCE ROOMS.....2

KITCHEN.....1

OPEN WORK AREA.....+/-18

KEY PLAN:

Not to scale, furniture and appliances not included

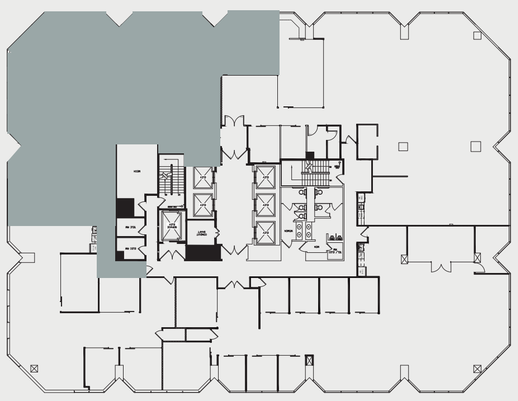

onni group