SUITE: 1500

RSF: 7,516

600 WILSHIRE

AS-BUILT CONFIGURATION

PRIVATE OFFICES.....6

CONFERENCE ROOMS.....2

KITCHEN.....2

OPEN WORK AREA.....+/-68

KEY PLAN:

Not to scale, furniture and appliances not included



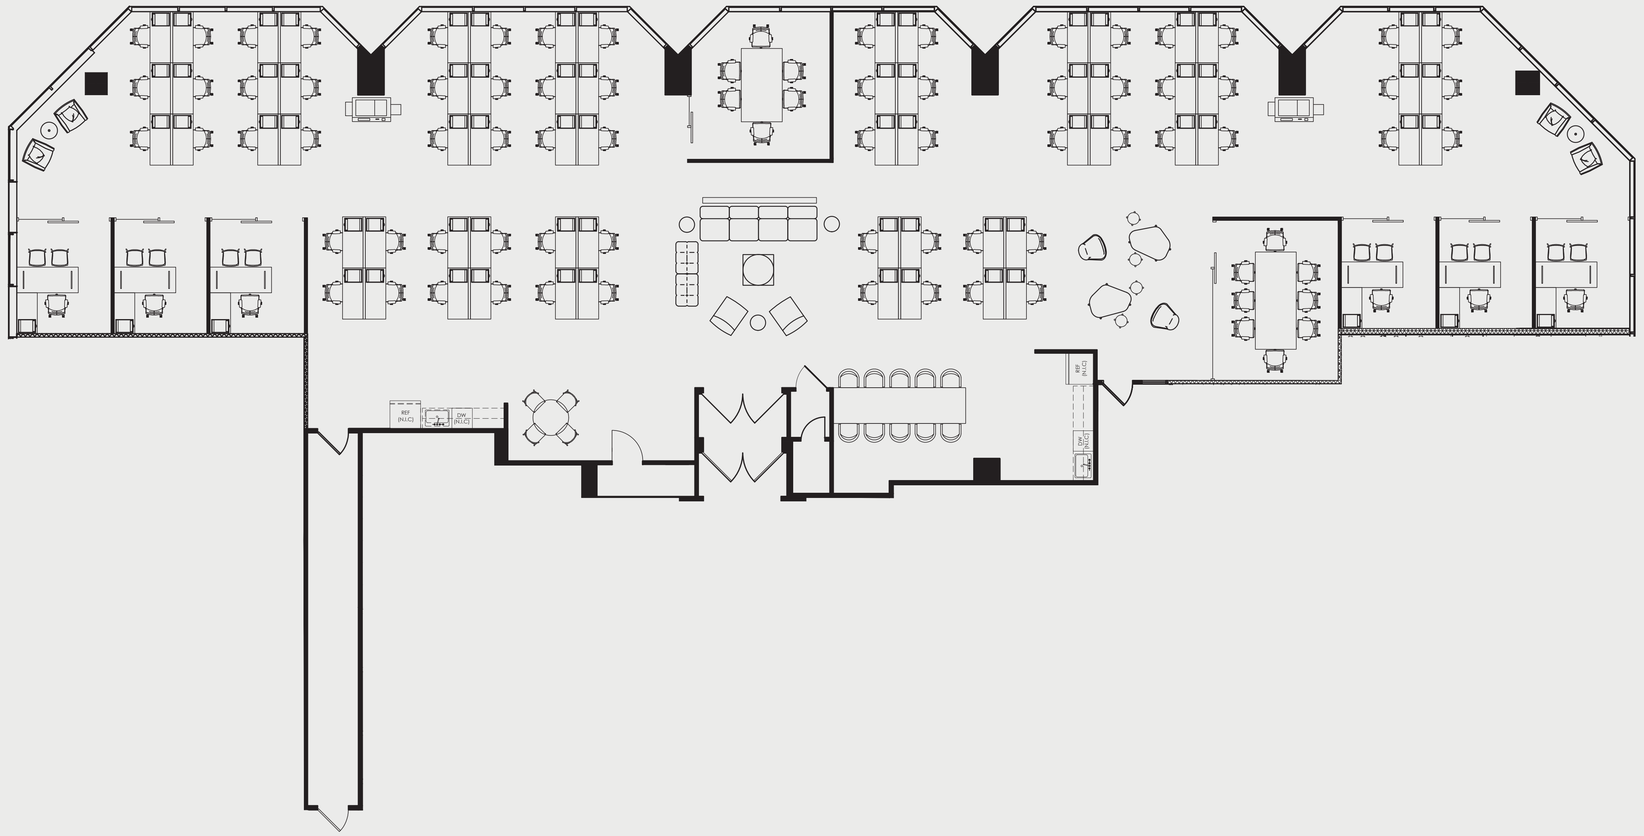

For leasing information please contact:
USALEASING@ONNI.COM

onni group