SUITE: 201 RSF: 2,830

600 WILSHIRE

AS-BUILT CONFIGURATION

PRIVATE OFFICES	4
RECEPTION	1
CONFERENCE ROOMS	1
KITCHEN	1
OPEN WORK AREA	+/-24

KEY PLAN:

Not to scale, furniture and appliances not included

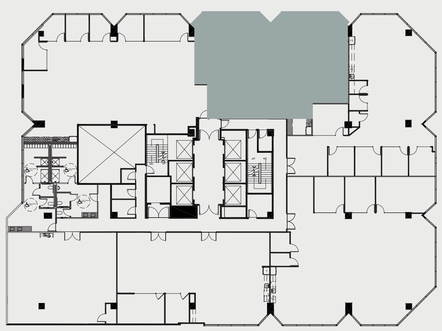

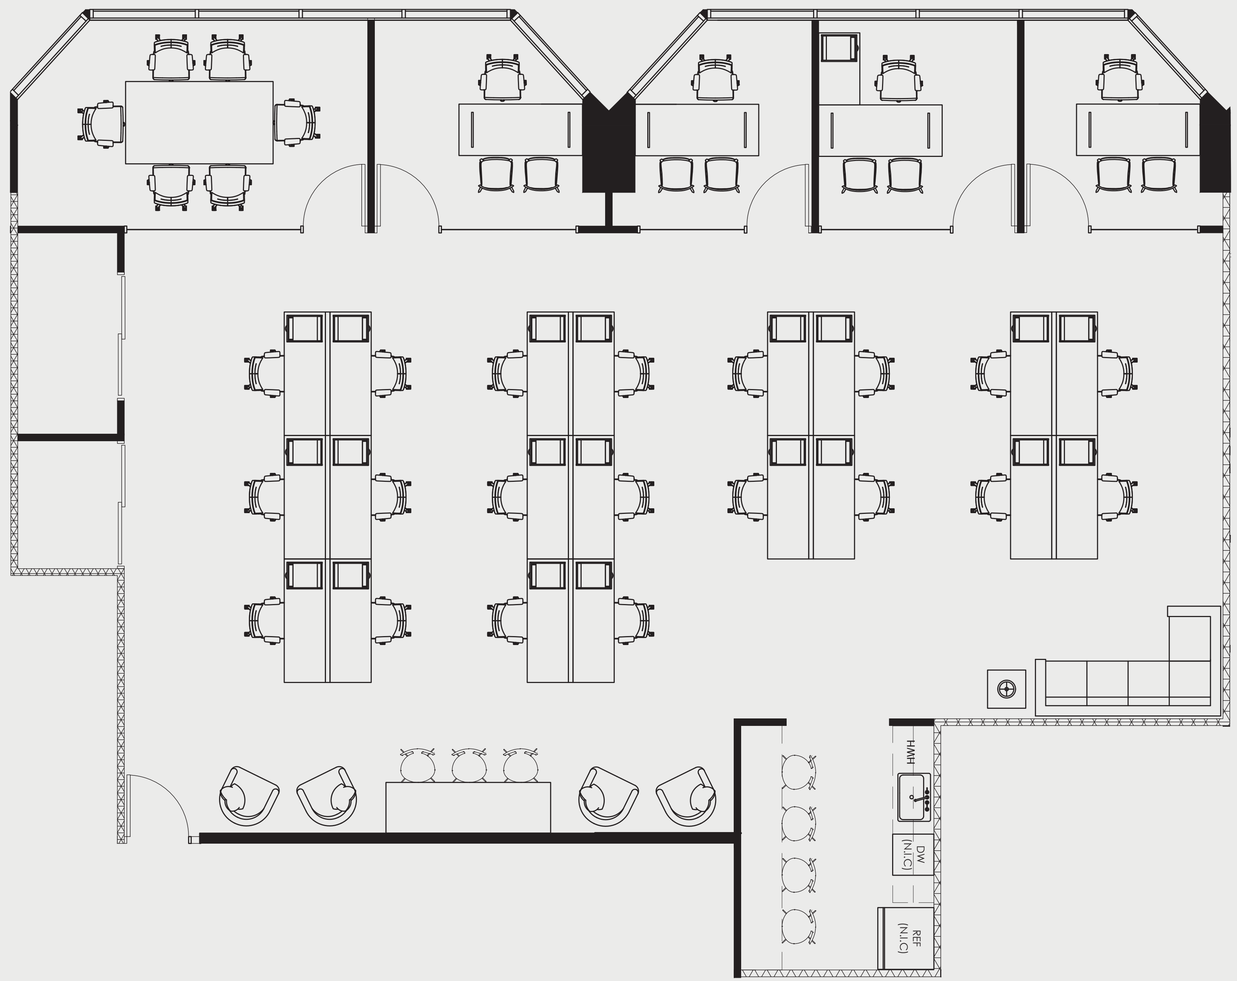

For leasing information please contact:
USALEASING@ONNI.COM
(213) 629-2041

onni group