SUITE: 760 RSF: 3,403

600 WILSHIRE

AS-BUILT CONFIGURATION

OFFICES.....3

RECEPTION.....1

CONFERENCE ROOMS.....1

KITCHEN.....1

OPEN WORK AREA.....+/-20

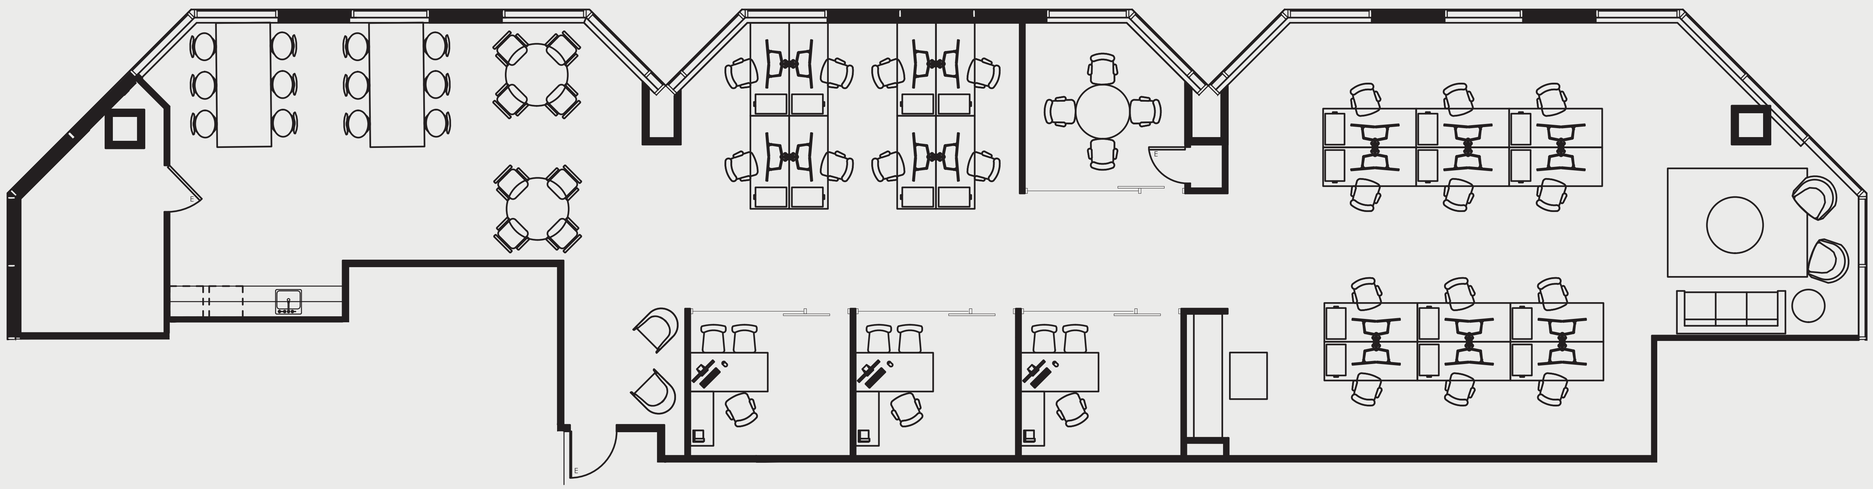

KEY PLAN:

Not to scale, furniture and appliances not included

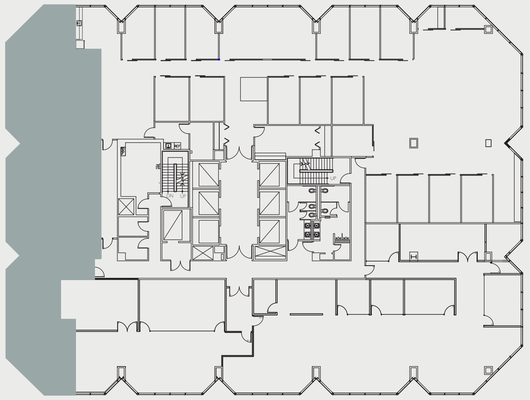

For leasing information please contact:
USALEASING@ONNI.COM
(213) 629-2041

onni group