# SUITE: 970

# RSF: 2,331

600 WILSHIRE

## AS-BUILT CONFIGURATION

PRIVATE OFFICES.....3

KITCHEN.....1

OPEN WORK AREA.....+/-10

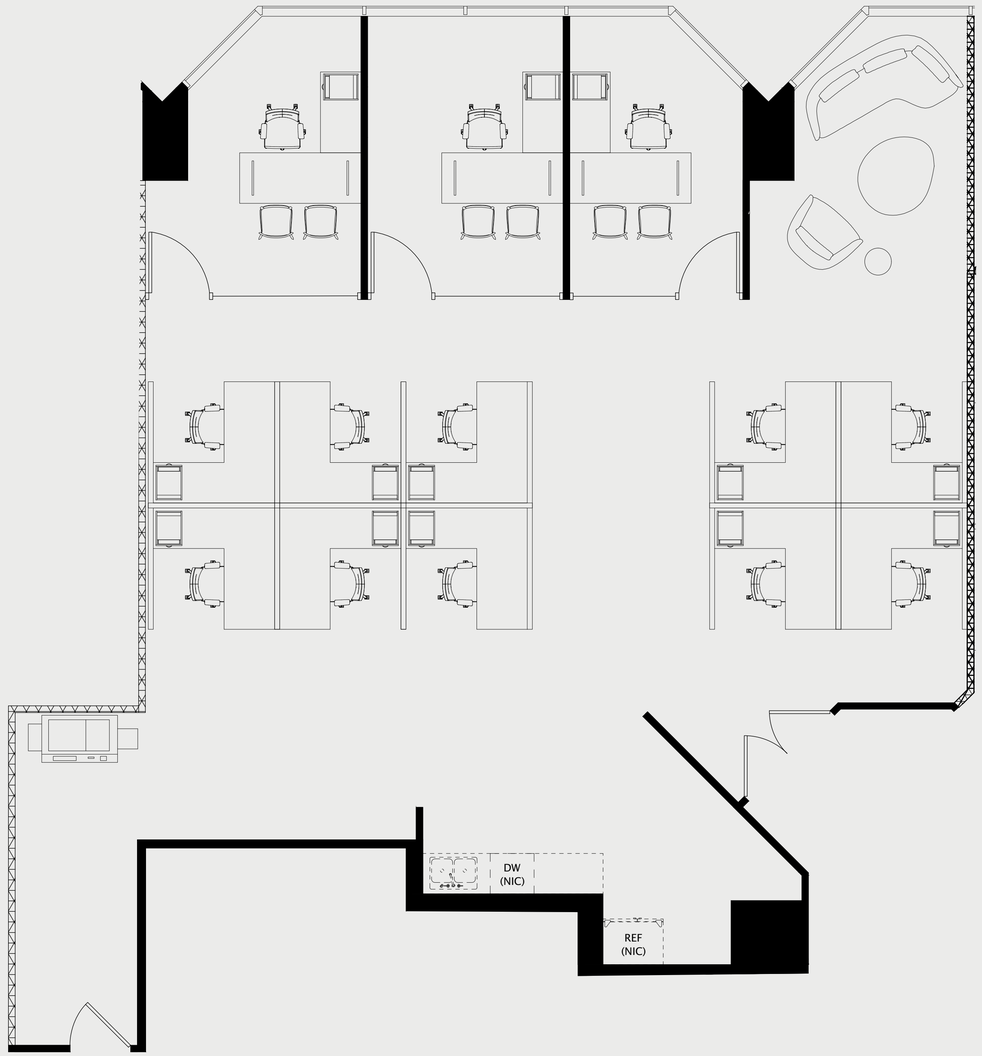


## KEY PLAN:

*Not to scale, furniture and appliances not included*

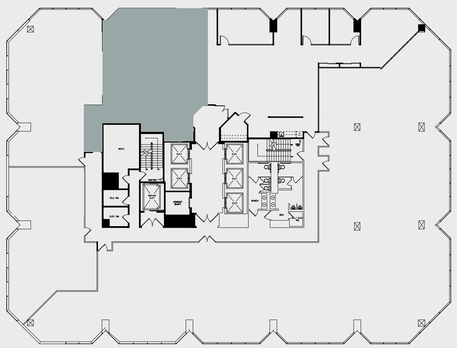

For leasing information please contact:
USALEASING@ONNI.COM

onni group